

STATE CORPORATION COMMISSION OF KANSAS
OIL & GAS CONSERVATION DIVISION
WELL COMPLETION OR RECOMPLETION FORM
ACO-1 WELL HISTORY
DESCRIPTION OF WELL AND LEASE

API NO. 15-199-20,118-00-00
County Wallace
C NE SE 8 14S 42 East
Sec Twp Rge X West

Operator: License # 4134
Name Douglas P. Meyer Oil Investments
Address 135 W. Fourth Street
Russell, KS 67665
City/State/Zip Box 1118
Longmont, Colorado 80501

1980
660
Ft North from Southeast Corner of Section
Ft West from Southeast Corner of Section
(Note: Locate well in section plat below)

Purchaser

Lease Name Welsh Well # 1

Operator Contact Person Douglas P. Meyer
Phone 913-483-4501

Field Name


Producing Formation

Elevation: Ground 3858 KB 3863

Contractor: License # 6033
Name Murfin Drilling Company

Wellsite Geologist
Phone

Section Plat

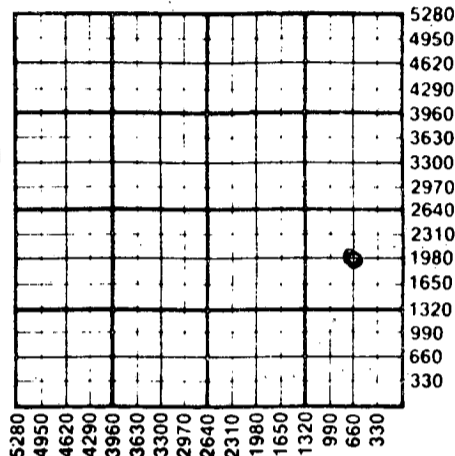

Designate Type of Completion
X New Well Re-Entry Workover
Oil SWD Temp Abd
Gas Inj Delayed Comp
X Dry Other (Core, Water Supply etc.)

RECEIVED
STATE CORPORATION COMMISSION
APR 18 1988
04-18-1988
CONSERVATION DIVISION
Wichita, Kansas

If OWO: old well info as follows:
Operator
Well Name
Comp. Date Old Total Depth

WATER SUPPLY INFORMATION
Disposition of Produced Water: Disposal
Docket # Repressuring

WELL HISTORY

Drilling Method: X Mud Rotary Air Rotary Cable
10-14-87 10-22-87 10-22-87
Spud Date Date Reached TD Completion Date
5150'
Total Depth PBSD
8-5/8" @ 610'
Amount of Surface Pipe Set and Cemented at feet
Multiple Stage Cementing Collar Used? Yes No
If yes, show depth set feet
If alternate 2 completion, cement circulated from feet depth to w/ SX cmt
Cement Company Name
Invoice #

Questions on this portion of the ACO-1 call:
Water Resources Board (913) 296-3717
Source of Water: Pumped.
Division of Water Resources Permit #
Groundwater Ft North from Southeast Corner (Well) Ft West from Southeast Corner of Sec Twp Rge East West
Surface Water Ft North from Southeast Corner (Stream, pond etc.) Ft West from Southeast Corner Sec Twp Rge East West
Other (explain) (purchased from city, R.W.D. #)

INSTRUCTIONS: This form shall be completed in triplicate and filed with the Kansas Corporation Commission, 200 Colorado Derby Building, Wichita, Kansas 67202, within 120 days of the spud date of any well. Rule 82-3-130, 82-3-107 and 82-3-106 apply. Information on side two of this form will be held confidential for a period of 12 months if requested in writing and submitted with the form. See rule 82-3-107 for confidentiality in excess of 12 months. One copy of all wireline logs and drillers time log shall be attached with this form. Submit CP-4 form with all plugged wells. Submit CP-111 form with all temporarily abandoned wells.

All requirements of the statutes, rules and regulations promulgated to regulate the oil and gas industry have been fully complied with and the statements herein are complete and correct to the best of my knowledge.

Signature Douglas P. Meyer

Title owner Date 11-1-87


Subscribed and sworn to before me this 11 day of 11 1987

Notary Public Ann L. Meyer

Date Commission Expires 3-28-90

K.C.C. OFFICE USE ONLY
F Letter of Confidentiality Attached
C Wireline Log Received
C Drillers Timelog Received
Distribution
KCC SWD/Rep NGPA
KGS Plug Other (Specify)
4-18-88

Sec. 8, Twp. 4, Rge. 4

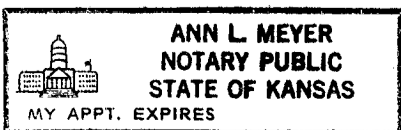

SIDE TWO

Operator Name Douglas P. Meyer Oil Investments Lease Name Welsh Well # 1

Sec. 8 Twp. 14S Rge. 42 East West County Wallace

WELL LOG

INSTRUCTIONS: Show important tops and base of formations penetrated. Detail all cores. Report all drill stem tests giving interval tested, time tool open and closed, flowing and shut-in pressures, whether shut-in pressure reached static level, hydrostatic pressures, bottom hole temperature, fluid recovery, and flow rates if gas to surface during test. Attach extra sheet if more space is needed. Attach copy of log.

Drill Stem Tests Taken Yes No
 Samples Sent to Geological Survey Yes No
 Cores Taken Yes No

Formation Description Log Sample

Name	Top	Bottom
Stone Corral	2858'	2887'
Topeka	3946'	
Heebner	4157'	
Toronto	4189'	
Lansing-KC	4216'	
Base of KC		4583'
Morrow Shale	5012'	
Morrow Lime	5089'	

CASING RECORD New Used
 Report all strings set-conductor, surface, intermediate, production, etc.

Purpose of String	Size Hole Drilled	Size Casing Set (In O.D.)	Weight Lbs/Ft.	Setting Depth	Type of Cement	#Sacks Used	Type and Percent Additives
Surface	12 1/2"	8-5/8"		610'	Lite Class C	180	2% cc
						100	2% cc

Shots Per Foot	Specify Footage of Each Interval Perforated	Acid, Fracture, Shot, Cement Squeeze Record (Amount and Kind of Material Used)	Depth

TUBING RECORD Size Set At Packer at Liner Run Yes No

Date of First Production Producing Method Flowing Pumping Gas Lift Other (explain).....

Estimated Production Per 24 Hours	Oil Bbls	Gas MCF	Water Bbls	Gas-Oil Ratio CFPB	Gravity

METHOD OF COMPLETION Production Interval

Disposition of gas: Vented Open Hole Perforation
 Sold Other (Specify)
 Used on Lease Dually Completed
 Commingled

WELSH
 WALLACE COUNTY
