

TYPE

AFFIDAVIT OF COMPLETION FORM

ACO-1 WELL HISTORY

Compt. _____

SIDE ONE

Two (2) copies of this form shall be filed with the Kansas Corporation Commission, 200 Colorado Derby Building, Wichita, Kansas 67202, within thirty (30) days after the completion of a well, regardless of how the well was completed.

F Attach separate letter of request if the information is to be held confidential. If confidential, only file one copy. Information on Side One will be of public record and Side Two will then be held confidential.

Applications must be made on dual completion, commingling, salt water disposal, injection and temporarily abandoned wells.

C Attach one copy only wireline logs (i.e. electrical log, sonic log, gamma ray neutron log, etc.). (Rules 82-2-105 & 82-2-125) KCC# (316) 263-3238. No Log

LICENSE # 7271 EXPIRATION DATE 6/30/84

OPERATOR Bartling Oil Company API NO. 15-071-20,298-00-00

ADDRESS 8550 Katy Freeway, Suite 128 COUNTY Greeley

Houston, Texas 77024 FIELD Byerly

** CONTACT PERSON Carl S. Graef PROD. FORMATION

PHONE 713-465-1093

PURCHASER LEASE Nazarene

ADDRESS WELL NO. 1

DRILLING CONTRACTOR KANDRILCO, INC. WELL LOCATION C NW NW SW ^{ADD KCC}

ADDRESS Bldg. 1, Suite 207, 555 North Woodlawn Ft. from Line and

Wichita, Kansas 67208 the SW (Qtr.) SEC 5 TWP 17 RGE 39 ^(E) _(W)

PLUGGING CONTRACTOR Halliburton WELL PLAT (Office Use Only)

ADDRESS Oberlin, Kansas 67749

TOTAL DEPTH 3000' PBTD

SPUD DATE 9-12-83 DATE COMPLETED 9-17-83

ELEV: GR 3562' DF KB 3570'


DRILLED WITH (CABLE) (ROTARY) (AIR) TOOLS.

DOCKET NO. OF DISPOSAL OR REPRESSURING WELL BEING USED TO DISPOSE OF WATER FROM THIS LEASE

Amount of surface pipe set and cemented 293.96' DV Tool Used? No

THIS AFFIDAVIT APPLIES TO: (Circle ONE) - Oil, Gas, Shut-in Gas, Dry, Disposal, Injection, Temporarily Abandoned, OWWO, Other

ALL REQUIREMENTS OF THE STATUTES, RULES AND REGULATIONS PROMULGATED TO REGULATE THE OIL AND GAS INDUSTRY HAVE BEEN FULLY COMPLIED WITH.

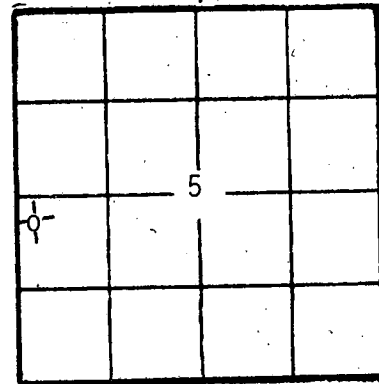

(Office Use Only) KCC, KGS, SWD/REP, PLG.

SEP 26 1983

CONSERVATION DIVISION Wichita, Kansas

A F F I D A V I T

Theodore A. Bartling, being of lawful age, hereby certifies that:

I am the Affiant, and I am familiar with the contents of the foregoing Affidavit. The statements and allegations contained therein are true and correct.

Theodore A. Bartling (Name)

SUBSCRIBED AND SWORN TO BEFORE ME this 23 day of September, 1983.


Carl S. Graef (NOTARY PUBLIC)

MY COMMISSION EXPIRES: 2-17-85

RECEIVED STATE CORPORATION COMMISSION

** The person who can be reached by phone regarding any questions concerning this information.

CONSERVATION DIVISION Wichita, Kansas

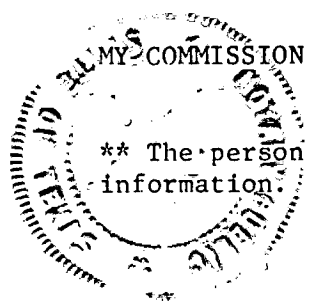

SIDE TWO

OPERATOR Bartling Oil Company LEASE Nazerene

ACO-1 WELL HISTORY (E)

SEC. 5 TWP. 17 RGE. 39 (W)

FILL IN WELL INFORMATION AS REQUIRED: WELL NO. _____

Show all important zones of porosity and contents thereof; cored intervals, and all drill-stem tests, including depth interval tested, cushion used, time tool open, flowing and shut-in pressures, and recoveries.

SHOW GEOLOGICAL MARKERS, LOGS RUN, OR OTHER DESCRIPTIVE INFORMATION.

FORMATION DESCRIPTION, CONTENTS, ETC.	TOP	BOTTOM	NAME	DEPTH
<input checked="" type="checkbox"/> Check if no Drill Stem Tests Run.			Neutron-Density Log	

If additional space is needed use Page 2, Side 2

Report of all strings set — surface, intermediate, production, etc. **CASING RECORD** (New) or (Used)

Purpose of string	Size hole drilled	Size casing set (in O.D.)	Weight lbs/ft.	Setting depth	Type cement	Sacks	Type and percent additives
Surface	12-1/4"	8-5/8"	24	305'	Class C	200	2% gel 3% cc

LINER RECORD

PERFORATION RECORD

Top, ft.	Bottom, ft.	Sacks cement	Shots per ft.	Size & type	Depth interval

TUBING RECORD		
Size	Setting depth	Packer set at

ACID, FRACTURE, SHOT, CEMENT SQUEEZE RECORD

Amount and kind of material used	Depth interval treated

Date of first production	Producing method (flowing, pumping, gas lift, etc.)	Gravity
--------------------------	---	---------

Estimated Production -I.P.	Oil bbls.	Gas MCF	Water %	Gas-oil ratio bbls.
----------------------------	-----------	---------	---------	---------------------

Disposition of gas (vented, used on lease or sold)	Perforations
--	--------------

