

CARD MUST BE TYPED

State of Kansas  
**NOTICE OF INTENTION TO DRILL**  
(see rules on reverse side)

CARD MUST BE SIGNED

Starting Date: November 20, 1984  
month day year

API Number 15- 169-20,266-0000

OPERATOR: License # 5606  
Name R. J. Walker Oil Co., Inc.  
Address 3535 N.W. 58th St. S-1000  
City/State/Zip Okla. City, OK 73112  
Contact Person O. N. Goode  
Phone (405) - 949-2440

East  
NE, NW, SE Sec .7. Twp 15. S, Rge .1.  West  
(location)

2285..... Ft North from Southeast Corner of Section  
1725..... Ft West from Southeast Corner of Section  
(Note: Locate well on Section Plat on reverse side)  
(Irregular Section)

CONTRACTOR: License # 5133  
Name Kansas Drilling & Well Serv. Inc  
City/State Marion, KS 66861

Nearest lease or unit boundary line 330.... feet.  
County Saline  
Lease Name H. Gillmore..... Well# 2-7.....

Well Drilled For: Well Class: Type Equipment:  
 Oil  Swd  Infield  Mud Rotary  
 Gas  Inj  Pool Ext.  Air Rotary  
 OWWO  Expl  Wildcat  Cable

Domestic well within 330 feet:  yes  no  
Municipal well within one mile:  yes  no

If OWWO: old well info as follows:

Operator .....  
Well Name .....  
Comp Date ..... Old Total Depth .....  
Projected Total Depth 3400..... feet  
Projected Formation at TD Simpson.....  
Expected Producing Formations L-KC, Miss, Viola, Simp

Depth to Bottom of fresh water 50..... feet  
Lowest usable water formation Wellington.....  
Depth to Bottom of usable water 200..... feet  
Surface pipe by Alternate: 1  2   
Surface pipe to be set 200..... feet  
Conductor pipe if any required Not Required..... feet  
Ground surface elevation 1290..... feet MSI  
This Authorization Expires 5-79-85

I certify that we will comply with K.S.A. 55-101, et seq., plus eventually plugging hole to K.C.C. specifications.

Date 11/14/1984 Signature of Operator or Agent O. N. Goode

Approved By 11-19-84 R

Title Engr.

MHC/KOHE 11/19/84


Must be filed with the K.C.C. five (5) days prior to commencing well  
 This card void if drilling not started within six (6) months of date received by K.C.C.

**Important procedures to follow :**

1. Notify District office before setting surface casing.
  2. Set surface casing by circulating cement to the top.
  3. File completion forms ACO-1 with K.C.C. within 90 days of well completion, following instructions on ACO-1, side 1, and including copies of wireline logs.
  4. Notify District office 48 hours prior to old well workover or re-entry.
  5. Prior to plugging, prepare a plugging plan, then obtain agreement from the appropriate district office for an approved plugging plan.
  6. Submit plugging report (CP-4) to K.C.C. after plugging is completed.
  7. Obtain an approved injection docket number before disposing of salt water.
- Notify K.C.C. within 10 days when injection commences or terminates.
- 90 day completion, cement in the production pipe from below any usable water to surface within 120 days of spud date.

SECTION 7  
 A Regular Section of Land  
 1 Mile = 5,280 Ft.  
 Range 1 West

Township 15 South

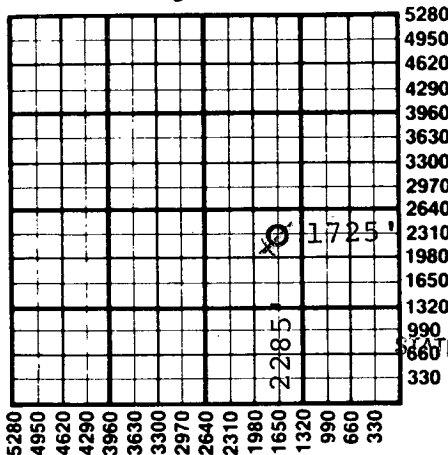

Irregular Section  
 Saline Co.

RECEIVED

STATE CORPORATION COMMISSION  
 CONSERVATION DIVISION

NOV 19 1984  
 11-19-84  
 CONSERVATION DIVISION  
 Wichita, Kansas

State Corporation Commission of Kansas  
 Conservation Division  
 200 Colorado Derby Building  
 Wichita, Kansas 67202  
 (316) 263-3238