


Give All Information Completely
Make Required Affidavit
Mail or Deliver Report to:
Conservation Division
State Corporation Commission
800 Bittling Building
Wichita, Kansas

WELL PLUGGING RECORD

15-169-00036-0000

NORTH

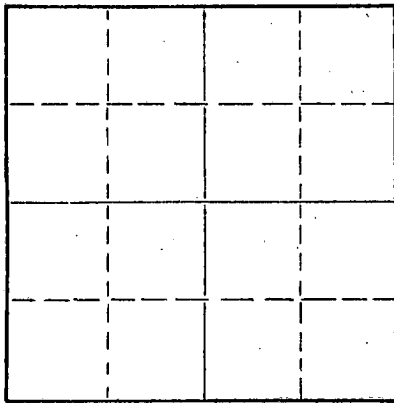

Locate well correctly on above
Section Plat

Saline County. Sec. 3 Twp. 16 Rge. 1 (E) 1 (W)
Location as "NE/CNW/SE" or footage from lines SW SW SE
Lease Owner Musgrove Petroleum Corporation
Lease Name EVERHART Well No. 1
Office Address 518 Petroleum Building, Wichita, Ks.
Character of Well (completed as Oil, Gas or Dry Hole) Dry hole
Date well completed October 16, 19 54
Application for plugging filed verbally October 16, 19 54
Application for plugging approved verbally October 16, 19 54
Plugging commenced October 16, 19 54
Plugging completed October 16, 19 54
Reason for abandonment of well or producing formation Dry hole

If a producing well is abandoned, date of last production 19
Was permission obtained from the Conservation Division or its agents before plugging was commenced? verbally - yes

Name of Conservation Agent who supervised plugging of this well _____

Producing formation _____ Depth to top _____ Bottom _____ Total Depth of Well 2680 Feet
Show depth and thickness of all water, oil and gas formations.

OIL, GAS OR WATER RECORDS

CASING RECORD

FORMATION	CONTENT	FROM	TO	SIZE	PUT IN	PULLED OUT
				8-5/8"	107'	

Describe in detail the manner in which the well was plugged, indicating where the mud fluid was placed and the method or methods used in introducing it into the hole. If cement or other plugs were used, state the character of same and depth placed, from _____ feet to _____ feet for each plug set.

Filled hole with mud to 106'.
Set first plug at 106' with 15 sx cement.
Filled hole with mud to 15'.
Set second plug at 15' with 5 sx cement.


(If additional description is necessary, use BACK of this sheet)
Name of Plugging Contractor Musgrove Petroleum Corporation,
Address 518 Petroleum Building, Wichita, Kansas.

STATE OF Kansas COUNTY OF Sedgwick
I, Gordon L. Koelling, (employee of owner) or (owner or operator) of the above-described well, being first duly sworn on oath, says: That I have knowledge of the facts, statements, and matters herein contained and the log of the above-described well as filed and that the same are true and correct. So help me God.

(Signature) Gordon L. Koelling
518 Petroleum Building, Wichita, Kansas.
(Address)

SUBSCRIBED AND SWORN to before me this 18th day of October, 19 54
September 24, 1954.

Shelma A. Semanay
Notary Public.

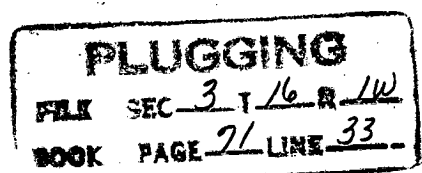

CONTRACTOR'S WELL LOG

COMPANY:	MUSGROVE PETROLEUM CORP.,
CONTRACTOR:	Musgrove Petroleum Corp.,
FARM:	EVERHART #1
LOCATION:	SW SW SE, Sec. 3-16-1W Saline County, Kansas.
COMMENCED:	October 8, 1954
COMPLETED:	October 16, 1954

0	25	Surface soil
25	107	Shale & lime
107	420	Shale & shells
420	850	Shale & lime
850	1280	Shale & shells
1280	1395	Shale & lime
1395	1610	Shale, shells, & lime stks.
1610	2680	Shale & lime
	2680	Rotary Total Depth

Set 8-5/8" surface pipe at 107' with 100 sacks cement.

Dry and Abandoned

STATE OF KANSAS)
) SS
COUNTY OF SEDGWICK)

I, GORDON L. KOELLING, do hereby certify that the above and foregoing is a true and correct copy of the log of the EVERHART #1, SW SW SE, Section 3-16-1W, Saline County, Kansas, as reflected by the files of the Musgrove Petroleum Corporation.

MUSGROVE PETROLEUM CORPORATION

BY

Gordon L. Koelling
Secretary-Treasurer

Subscribed and sworn to before me, a Notary Public, in and for Sedgwick County, Kansas, this 18th day of October, 1954.

Thomas L. Simpson
Notary Public

My commission expires September 24, 1956.

PLUGGING

