


STATE OF KANSAS  
STATE CORPORATION COMMISSION

15-169-00748-0000

WELL PLUGGING RECORD

Give All Information Completely  
Make Required Affidavit  
Mail or Deliver Report to:  
Conservation Division  
State Corporation Commission  
212 North Market, Insurance Bldg.  
Wichita, Kansas

Saline County. Sec. 4 Twp. 16 Rge. 1 West (W)  
Location as "NE/CNW/SW" or footage from lines Southeast line NW NW  
Lease Owner I. O. Miller  
Lease Name Mortimer Well No. 3  
Office Address 619 Brown Building, Wichita, Kansas  
Character of Well (completed as Oil, Gas or Dry Hole) dry hole  
Date well completed Jan. 17, 1961 19  
Application for plugging filed " " " 19  
Application for plugging approved " " " 19  
Plugging commenced " " " 19  
Plugging completed " " " 19  
Reason for abandonment of well or producing formation dry hole  
If a producing well is abandoned, date of last production \_\_\_\_\_ 19  
Was permission obtained from the Conservation Division or its agents before plugging was commenced? yes

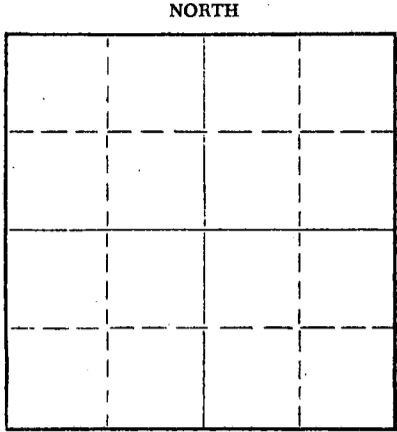

Locate well correctly on above Section Plat

Name of Conservation Agent who supervised plugging of this well Gilbert Toman  
Producing formation \_\_\_\_\_ Depth to top \_\_\_\_\_ Bottom \_\_\_\_\_ Total Depth of Well \_\_\_\_\_ Feet  
Show depth and thickness of all water, oil and gas formations.

OIL, GAS OR WATER RECORDS

CASING RECORD

FORMATION	CONTENT	FROM	TO	SIZE	PUT IN	PULLED OUT

Describe in detail the manner in which the well was plugged, indicating where the mud fluid was placed and the method or methods used in introducing it into the hole. If cement or other plugs were used, state the character of same and depth placed, from \_\_\_\_\_ feet to \_\_\_\_\_ feet for each plug set. Filled hole w/ mud to 190'; set plug and 10 sacks cement; filled hole with mud to 25'; set plug and 5 sacks cement; bridged rat hole with 2 sacks cement

RECEIVED  
STATE CORPORATION COMMISSION  
2661  
FEB 6 1961

CONSERVATION DIVISION  
Wichita, Kansas

(If additional description is necessary, use BACK of this sheet)  
Name of Plugging Contractor Eureka Drilling Company  
Address Hamilton, Kansas

STATE OF Kansas, COUNTY OF Greenwood, ss. \_\_\_\_\_ (employee of owner) or (owner or operator) of the above-described well, being first duly sworn on oath, says: That I have knowledge of the facts, statements, and matters herein contained and the log of the above-described well as filed and that the same are true and correct. So help me God.

(Signature) Harry Martell  
Hamilton, Kansas  
Address

SUBSCRIBED AND SWORN to before me this 2 day of Feb, 1961  
WALKER ELLIS, NOTARY PUBLIC  
Greenwood County, Kansas  
My commission expires Oct. 9, 1962  
Walker Ellis  
Notary Public.



15-169-00748-0000

**EUREKA DRILLING CO.**  
 ROTARY TOOLS  
 HAMILTON, KANSAS

Company: I. O. Miller  
 Farm: Mortimer  
 Well: #3  
 Location: Southeast Line NE NW 4-16-1W-Saline County  
 Date: Commenced Jan. 11, 1961  
 Completed Jan. 17, 1961

Casing Record: 201 feet of 7" surface casing

Elevation:

Contractor: Eureka Drilling Company

W&G 3

Figures indicate bottoms of formations from the rotary table bushings which are 5½ feet above ground level;-

10 soil  
 70 shale and shells  
 330 lime  
 560 shale and lime  
 585 lime  
 730 shale and lime  
 1545 shale and shells  
 1705 shale and lime  
 1740 lime  
 1800 lime and shale  
 1880 shale  
 1940 shale and sand  
 1955 shale, lime and red rock  
 2140 lime  
 2159 lime and shale  
 2310 lime  
 2365 shale  
 2630 shale and lime  
 2652 lime  
 2652 RTD

**RECEIVED**  
 STATE CORPORATION COMMISSION

FEB 6 1961

CONSERVATION DIVISION  
 Wichita, Kansas