

EFFECTIVE DATE: 4-20-91

REVISED
State of Kansas

Correction
FORM MUST BE SIGNED
ALL BLANKS MUST BE FILLED

NOTICE OF INTENTION TO DRILL 15-199-20198-

Must be approved by the K.C. five (5) days prior to commencing well

Expected Spud Date May 20 1991
month day year

*SW NE SE Sec 31 Twp 14 S, Rg 40 East West

OPERATOR: License # 03384
Name: Sullivan and Company
Address: Suite 1700, 320 S. Boston
City/State/Zip: Tulsa, OK 74103
Contact Person: Dale E. Dawson
Phone: (918) 584-4288

2200 feet from South line of Section
1050 feet from East line of Section
(Note: Locate well on Section Plat on Reverse Side)

CONTRACTOR: License #: _____
Name: contractor not yet chosen

Well Drilled For: Well Class: Type Equipment:
 Oil ... Inj ... Infield Mud Rotary
... Gas ... Storage ... Pool Ext. ... Air Rotary
... OWWO ... Disposal Wildcat ... Cable
... Seismic; ... # of Holes

County: Wallace
Lease Name: W. Woodmancy Well #: 1
Field Name: W/C
Is this a Prorated Field? ... yes no
Target Formation(s): Miss
Nearest lease or unit boundary: 1050'
Ground Surface Elevation: 370.4 feet MSL
Domestic well within 330 feet: ... yes no
Municipal well within one mile: ... yes no
Depth to bottom of fresh water: 200
Depth to bottom of usable water: 1850'
Surface Pipe by Alternate: ... 1 2
*Length of Surface Pipe Planned to be set: 350
*Length of Conductor pipe required: as directed
Projected Total Depth: 5300
Formation at Total Depth: Miss
Water Source for Drilling Operations:
... well farm pond other

If OWWO: old well information as follows:
Operator: _____
Well Name: _____
Comp. Date: _____ Old Total Depth _____

Directional, Deviated or Horizontal wellbore? ... yes no
If yes, total depth location: _____

DWR Permit #: _____
Will Cores Be Taken?: ... yes no
If yes, proposed zone: _____

WAS: NE NW SE; 2310 FSL; 1650 FEL;
Alt 1; Surface Pipe Req = 1900'

AFFIDAVIT

15: 2200 FSL; 1050 FEL; SW NE SE;
ALT 2; Surface Pipe Req = 350'

The undersigned hereby affirms that the drilling, completion and eventual plugging of this well will comply with K.S.A. 55-101, et. seq.

- It is agreed that the following minimum requirements will be met:
1. The appropriate district office shall be notified before setting surface pipe;
 2. The minimum amount of surface pipe as specified above shall be set by circulating cement to the top; in all cases surface pipe shall be set through all unconsolidated materials plus a minimum of 20 feet into the underlying formation;
 3. If the well is dry, a plugging proposal shall be submitted to the district office. An agreement between the operator and the district office on plug length and placement is necessary prior to plugging;
 4. The appropriate district office will be notified before well is either plugged or production casing is cemented in;
 5. If an Alternate II completion, production pipe shall be cemented from below any usable water to surface within 120 days of spud date. In all cases, notify district office prior to any cementing.
- I hereby certify that the statements made herein are true and to the best of my knowledge and belief.

Date: 05/01/91 Signature of Operator or Agent: Dale E. Dawson Title: Production & Operations Manager

FOR KCC USE:
API # 15- 199-20,198-00-00
Conductor pipe required None feet
Minimum surface pipe required 350 feet, per Alt. 2
Approved by: MEW 5-9-91; sig 4-15-91
EFFECTIVE DATE: 4-20-91
This authorization expires: 10-15-91
(This authorization void if drilling not started within 6 months of effective date.)
Spud date: _____ Agent: _____

RECEIVED
STATE CONSERVATION COMMISSION
05-06-91
MAY 6 1991
CONSERVATION DIVISION
Wichita, Kansas

REMEMBER TO:

- File Drill Pit Application (form CDP-1) with Intent to Drill;
- File Completion Form ACO-1 within 120 days of spud date;
- File acreage attribution plat according to field proration orders;
- Notify appropriate district office 48 hours prior to workover or re-entry;
- Submit plugging report (CP-4) after plugging is completed;
- Obtain written approval before disposing or injecting salt water.

31
14
MOW


PLAT OF ACREAGE ATTRIBUTABLE TO A WELL

State Corporation Commission, Conservation Division
200 Colorado Derby Bldg. Wichita, Kansas 67202

OPERATOR <u>Sullivan and Company</u>	LOCATION OF WELL:
LEASE <u>W. Woodmancy</u>	<u>2200</u> feet north of SE corner
WELL NUMBER <u>1</u>	<u>1050</u> feet west of SE corner
FIELD <u>W/C</u>	Sec. <u>31</u> T <u>14S</u> R <u>40</u> $\frac{1}{2}$ W
	COUNTY <u>Wallace</u>
NO. OF ACRES ATTRIBUTABLE TO WELL <u>160</u>	IS SECTION <u>X</u> REGULAR <u> </u> IRREGULAR?
DESCRIPTION OF ACREAGE <u>SE/4</u>	IF IRREGULAR, LOCATE WELL FROM NEAREST CORNER BOUNDARY.

NOTE: If plat depicted is insufficient for your circumstances, you may attach your own scaled or surveyed plat.

40 W
PLAT

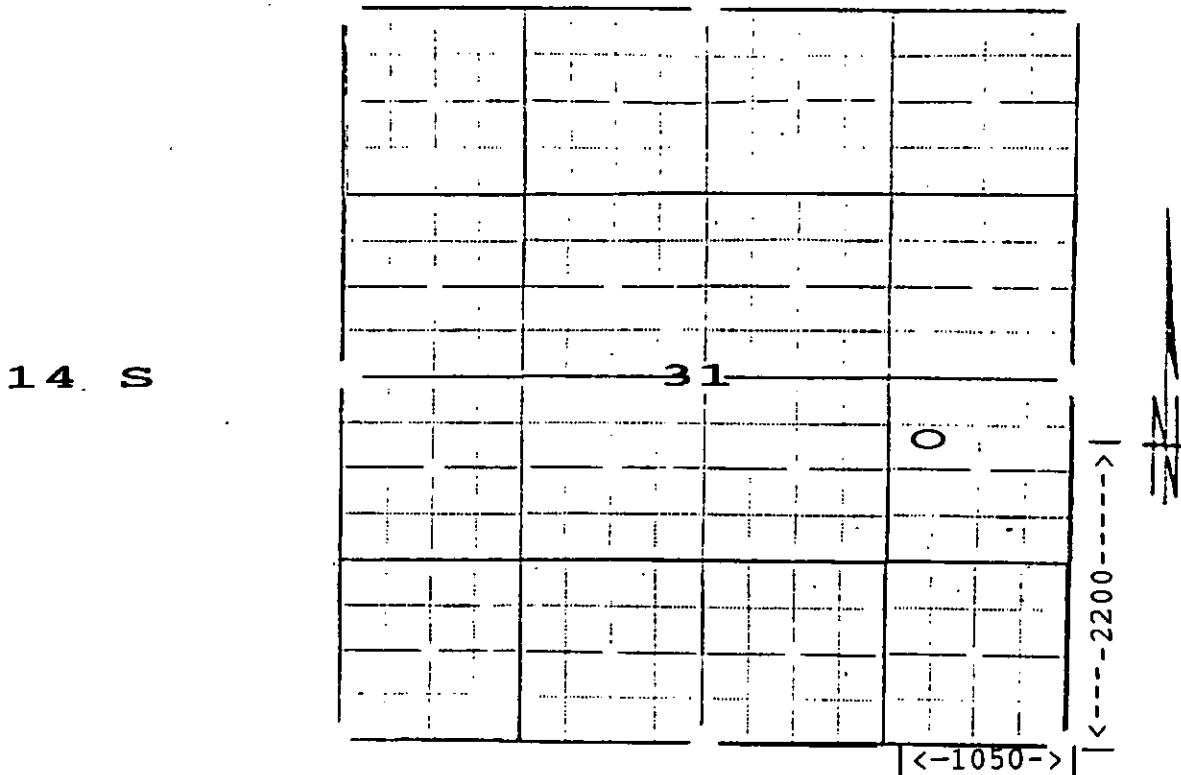

In plotting the proposed location of the well, you must show:

- 1) The manner in which you are using the depicted plat by identifying section lines, i.e. 1 section, 1 section with 8 surrounding partial sections, 4 sections, 16 sections, etc.;
- 2) the well's location relative to the location of other wells producing from the same common source of supply in adjoining drilling units, pursuant to K.A.R. 82-3-108, 82-3-207, 82-3-312, or special orders of the Commission;
- 3) the distance of the proposed drilling location from the section's east and south lines; and
- 4) the distance to the nearest lease or unit boundary line.

I hereby certify that the statements made herein are true and to the best of my knowledge and belief.

Signature of Operator or Agent *John E. Spawm*
Date 05/01/91 Title Production & Operations Manager