


15-199-20117-00-00

EXISTING WELL BORE SCHEMATIC
Akers "A" #1
SW Stockholm Field

RECEIVED
KANSAS CORPORATION COMMISSION

OCT 31 2002

CONSERVATION DIVISION
WICHITA, KS

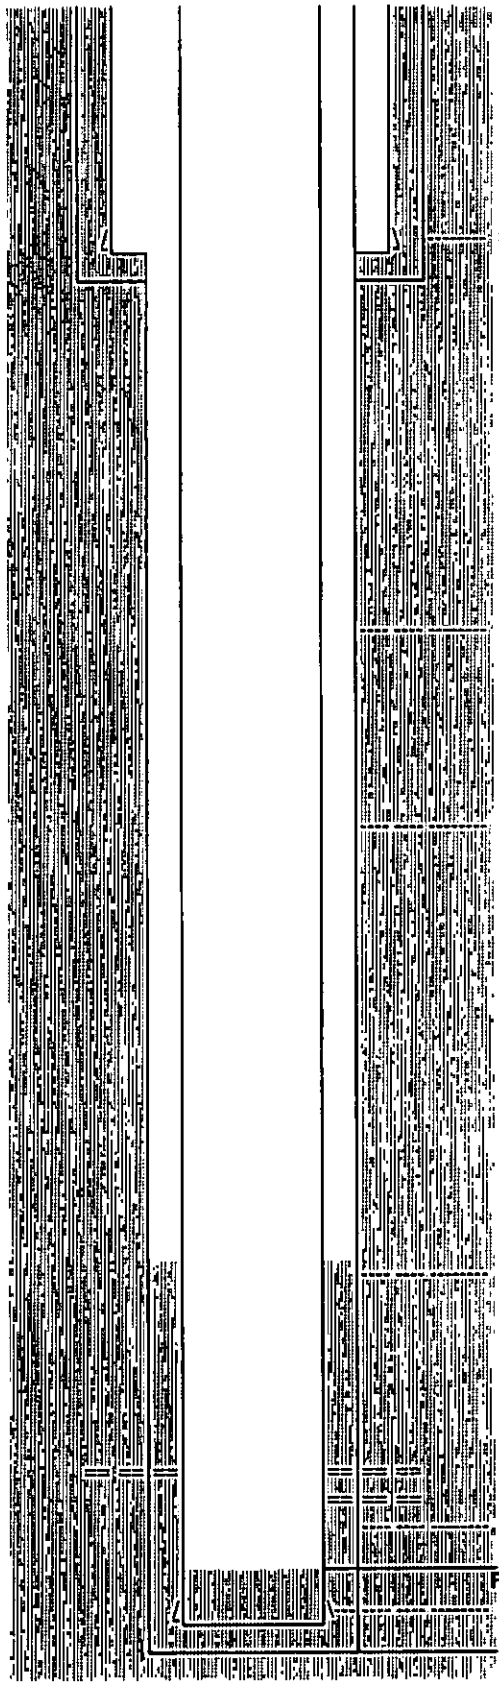

Surface Casing: 514'
8 5/8", 24#, K-55
175 Sks LITE; 100 Class "C"

Dakota Top: 1512'

Cheyenne Top: 1860'

Cement Top: 0'

Formation: 0'
Perforations: 5120'
5125'

Prod. Csg.: 4 1/2", 10.5#, K-55

FLOAT COLLAR: 5257'
EOC: 0'
TD: 5300'



15-199-20117-00-00

Kansas Corporation Commission

Bill Graves, Governor John Wine, Chair Cynthia L. Claus, Commissioner Brian J. Moline, Commissioner

NOTICE OF RECEIPT OF WELL PLUGGING APPLICATION (CP-1)

RME Petroleum Company
1201 Lake Robbins Drive
The Woodlands, TX 77380

November 21, 2002

Re: AKERS A #1
API 15-199-20117-00-00
S2S2S2 12-15S-43W, 330 FSL 330 FWL
WALLACE COUNTY, KANSAS

Dear Operator:

This letter is to notify you that the Conservation Division is in receipt of your plugging proposal, form CP-1, for the above-captioned well.

Your CP-1 has been reviewed by the Conservation Division central office for completeness and to verify license numbers. The plugging proposal will now be forwarded to the district office listed below for review of your proposed method of plugging.

Please contact the district office for approval of your proposed plugging method at least five (5) days before plugging the well, pursuant to K.A.R. 82-3-113 (b). If a workover pit will be used during the plugging of the well it must be permitted. A CDP-1 form must be filed and approved prior to the use of the pit.

The Conservation Division's review of form CP-1, either in the central or district office, does not include an inquiry into well ownership or the filing operator's legal right to plug the well.

This notice in no way constitutes authorization to plug the above-captioned well by persons not having legal rights of ownership or interest in the well. This notice is void after ninety (90) days from the above date.

District: #4
2301 E. 13th
Hays, KS 67601
(785) 625-0550

Sincerely

David P. Williams
Production Supervisor