

15-053-20085-00-00

STATE OF KANSAS
STATE CORPORATION COMMISSION

Form CP-4

Give All Information Completely
Make Required Affidavit
Mail or Deliver Report to:
Conservation Division
State Corporation Commission
212 No. Market
Wichita, Kansas


WELL PLUGGING RECORD

ELLSWORTH

County, Sec. 17 Twp. 14 Rge. 10 (E) (W) West

Location as "NE/CNW/SE/SW" or footage from lines E $\frac{1}{2}$ of W $\frac{1}{2}$ of the NE $\frac{1}{4}$
Lease Owner Ehrlich Drilling Company
Lease Name Sibrava Well No. 2
Office Address P. O. Box 173, Wilson, Kansas 67490
Character of Well (completed as Oil, Gas or Dry Hole) dry hole
Date well completed April 26 19 69
Application for plugging filed July 14 19 69
Application for plugging approved 19
Plugging commenced May 14, at 9 a. m. 19 69
Plugging completed: May 14, at 11 a. m. 19 69
Reason for abandonment of well or producing formation dry hole

NORTH

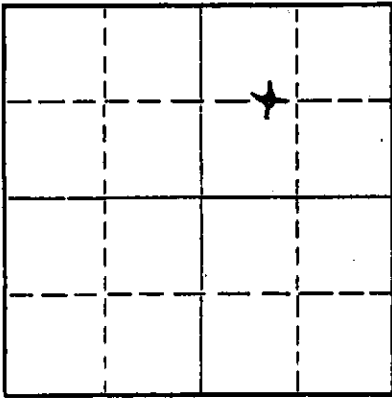

Locate well correctly on above
Section Flat

If a producing well is abandoned, date of last production _____ 19____
Was permission obtained from the Conservation Division or its agents before plugging was commenced? yes, verbally.

Name of Conservation Agent who supervised plugging of this well Gilfort Tollman Gilbert Toman, Holyrood, Kansas
Producing formation none Depth to top _____ Bottom _____ Total Depth of Well 3005 Feet
Show depth and thickness of all water, oil and gas formations.

OIL, GAS OR WATER RECORDS

CASING RECORD

FORMATION	CONTENT	FROM	TO	SIZE	PUT IN	PULLED OUT
surface water		38	68	8 5/8ths	227	none
	Surface casing cemented by Globe Oil Well Cementing Inc., Great Bend, Kansas 67530 on April 14, 1969, by their invoice # 11645.					
oil and gas	none					

Describe in detail the manner in which the well was plugged, indicating where the mud fluid was placed and the method or methods used in introducing it into the hole. If cement or other plugs were used, state the character of same and depth placed, from _____ feet to _____ feet for each plug set.

Filled hole with drilling mud with rotary mud pump.
First plug set at 220 feet with 25 sacks of common cement.
Second solid plug set at 35 feet with 10 sacks of common cement.

Pump & plugging of cement by Globe Oil Well Cementing, Inc.
Great Bend, Kansas, on May 14, 1969, by their invoice # 14377

The plugging was under the supervision or instructions of Gilfort Tollman.

RECEIVED
STATE CORPORATION COMMISSION
AUG 1 1969
CONSERVATION DIVISION
Wichita, Kansas


(If additional description is necessary, use BACK of this sheet)
Name of Plugging Contractor Ehrlich Drilling Company
Address P. O. Box 173, Wilson, Kansas 67490.

STATE OF KANSAS COUNTY OF ELLSWORTH ss.
R. B. Schmidt, consulting geologist of (employee of owner) or (owner or operator) of the above-described well, being first duly sworn on oath, says: That I have knowledge of the facts, statements, and matters herein contained and the log of the above-described well as filed and that the same are true and correct. So help me God.

(Signature) R. B. Schmidt
1219 College Avenue, Topeka, Kansas 66604

Subscribed and sworn to before me this 15 th day of July 19 69

(Address) Seward D. Greiner
Notary Public.

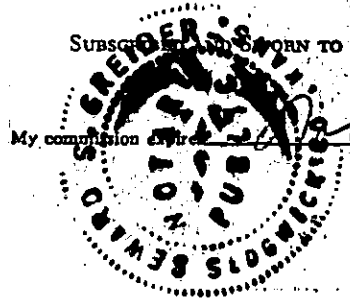

NO. 2 SIERAVA

Well Log:

Location: Ctr. E $\frac{1}{2}$ of W $\frac{1}{2}$ of the NE $\frac{1}{4}$ of Section 17, Township 14 South, Range 10 West, Ellsworth County, Kansas. Commenced: April 12, 1969

Operator: Ehrlich Drilling Company et. al. P. O. Box 173 Wilson, Kansas Completed: April 26, 1969 (Rotary) Plugged: May 14, 1969

Contractor: Ehrlich Drilling Company P. O. Box 173 Wilson, Kansas 67490 Elevation: 1757 K. B. Production: D & A

Casing Record: 8 - 5/8th inch @ 227 feet with 75 sacks of common cement.

- * * * L O G * * * -

(Figures indicate bottom of formation)

Surface clay	30	Shale & Lime	2093
sand	68	Brown lime	2103
Shale & clay	103	Lime & shale	2136
Lime	226	Gray lime	2140
Shale	317	Sandy & shale	2169
Lime & pyrite	324	White lime	2171
Sand	346	Shale & sand	2220
Lime soft	454	Lime	2256
Lime hard	461	Sand	2262
Shale & lime	586	Shale	2287
Anhydrite	611	Lime	2366
Shale	976	Lime & shale	2433
Salt	1151	Lime hard	2438
Lime & shale	1280	Limy shale	2508
Lime	1296	Shale	2512
Shale & lime	1396	Brown xyn lime	2520
Fine gray sand	1402	Gray Foss. lime	2556
Gray lime	1436	Hard white lime	2602
White & gray sand	1442	Shale	2604
Shale & lime	1471	Lime & Shale	2626
Lime	1486	Soft lime	2644
Shale	1508	Buff, white lime	2764
Lime hard	1602	Black shale	2768
Shale & lime	1680	Lime, gray shale	2787
Lime hard	1720	White, buff w cherty lime	2802
Shale & lime	1835	Green shale, sand, pyrite	2860
Lime & shale	2001	Dense brown lime	2883
Shale	2012	Gray Foss lime	2889
Lime	2040	Off white oolitic to Colicastic lime in part	2938
Saaley Lime	2056	Dense white & tan lime	2958
		White chalky lime	3005 R. T. D.

The undersigned, EHRLECH DRILLING COMPANY, does hereby certify that the above log is a true and correct log of the formations encountered in drilling the above well as reflected by the daily drilling reports.

STATE OF KANSAS)
) ss.
 COUNTY OF, Sedgwick)

EHRLECH DRILLING COMPANY
 By: *Richard B. Schmidt*
 Richard B. Schmidt, geologist for
 Julius Ehrlich, Tom Ehrlich,
 OPERATOR

Subscribed and sworn to before me this 30th day of July, 1969.
[Signature]
 Notary Public
 My Commission expires: 11-16-70

RECEIVED
 STATE CORPORATION COMMISSION
 JUL 30 1969
 CONSERVATION DIVISION
 Wichita, Kansas