


WELL PLUGGING RECORD

Give All Information Completely  
Make Required Affidavit  
Mail or Deliver Report to:  
Conservation Division  
State Corporation Commission  
211 No. Broadway  
Wichita, Kansas

NORTH

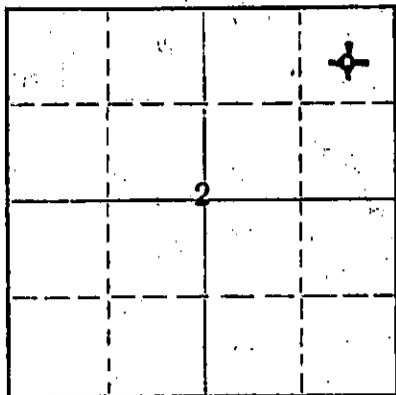

Locate well correctly on above  
Section Plat

Wallace County, Sec. 2 Twp. 14S Rge. 39W (W)  
Location as "NE/CNW/SW" or footage from lines C NE NE  
Lease Owner D. R. Lauck Oil Company, Inc.  
Lease Name Jennings Well No. 1  
Office Address 301 S. Broadway, Wichita, Kansas  
Character of Well (completed as Oil, Gas or Dry Hole) Dry Hole  
Date well completed September 15, 1965  
Application for plugging filed September 15, 1965  
Application for plugging approved September 15, 1965  
Plugging commenced September 15, 1965  
Plugging completed September 15, 1965  
Reason for abandonment of well or producing formation Dry Hole

If a producing well is abandoned, date of last production \_\_\_\_\_ 19\_\_\_\_  
Was permission obtained from the Conservation Division or its agents before plugging was commenced? Yes

Name of Conservation Agent who supervised plugging of this well Bill Nichols  
Producing formation \_\_\_\_\_ Depth to top \_\_\_\_\_ Bottom \_\_\_\_\_ Total Depth of Well 4868 Feet  
Show depth and thickness of all water, oil and gas formations.

OIL, GAS OR WATER RECORDS

CASING RECORD

FORMATION	CONTENT	FROM	TO	SIZE	PUT IN	PULLED OUT
		0'	209'	8-5/8"	209'	None

Describe in detail the manner in which the well was plugged, indicating where the mud fluid was placed and the method or methods used in introducing it into the hole. If cement or other plugs were used, state the character of same and depth placed, from \_\_\_\_\_ feet to \_\_\_\_\_ feet for each plug set.

4868'-660' Mud  
660'-656' Plug  
656'-616' Cement, 20 sacks  
616'-210' Mud  
210'-206' Plug  
206'-166' Cement, 20 sacks  
166'- 40' Mud  
40'- 36' Plug  
36'- 6' Cement, 10 sacks (Bottom of Cellar)

RECEIVED  
STATE CORPORATION COMMISSION  
SEP 24 1965  
CONSERVATION DIVISION  
WICHITA, KANSAS

(If additional description is necessary, use BACK of this sheet)  
Name of Plugging Contractor Lauck Drilling Company, Incorporated  
Address 301 S. Broadway, Wichita, Kansas

STATE OF KANSAS, COUNTY OF SEDGWICK, ss.  
John H. Knightley (employee of owner) or (owner or operator) of the above-described well, being first duly sworn on oath, says: That I have knowledge of the facts, statements, and matters herein contained and the log of the above-described well as filed and that the same are true and correct. So help me God.

(Signature) John H. Knightley  
301 S. Broadway, Wichita, Kansas  
(Address)

Subscribed and Sworn to before me this 23rd day of September, 19 65

My commission expires March 12, 1967  
Stella J. Lipe Notary Public.

D. R. Lauck Oil Company, Inc

Jennings #1

C NE NE Sec. 2-14S-39W  
Wallace County, Kansas

Commenced: September 1, 1965  
Completed: September 15, 1965

Casing Record: 209' 8-5/8" Cemented with 165 sacks Cement,  
4 sacks Calcium Chloride.

Elevation: 3363 GL; 3366 DF; 3368 KB.

Drillers Log

Tops

		Samples	Welex
Shale	830		
Chalky Lime	905		
Shale & Shells	1205	Blaine	1990+1378
Sand & Shale	1270	Cimarron Anhydrite	2560+808
Shale & Shells	1660	Topeka	3764-396 3760-392
Shale & Lime Streaks	2085	Heebner	3911-543 3909-541
Red Bed & Shells	2347	Toronto	3931-563 3931-563
Anhydrite & Red Bed	2540	Lansing	3962-594 3959-591
Red Bed	2575	Base Kansas City	4345-977 4343-975
Anhydrite	2605	Marmaton	4363-995 4364-996
Shale & Lime	2930	Cherokee	4491-1123 4490-1122
Lime & Shale	3400	Morrow Shale	4676-1308 4673-1305
Shale & Lime	3525	Morrow Sand	4710-1342 4712-1344
Lime & Shale	3615	Mississippian	4791-1423 4789-1421
Lime	3710	Ste. Genevieve	4791-1423 4789-1421
Shale & Lime	3790	St. Louis	4822-1454 4817-1449
Lime	3911	Total Depth	4868-1500 4867-1499
Heebner	3913		
Lime	4140		
Lime, cherty	4175	DST - None.	
Lime	4218		
Lime (dense), some cherty	4260		
Lime	4478		
Lime & Shale	4511	D&A	
Lime	4700		
Lime & Sand	4725		
Lime	4868	RTD	

I hereby certify that this is a true and correct log of the above mentioned well, to the best of my knowledge and belief.

*John H. Knightley*  
Subscribed and sworn to before me this

23<sup>rd</sup> day of September 1965.

*Stella J. Lipp*  
Notary Public

My commission expires 3-12-67

RECEIVED  
STATE CORPORATION COMMISSION

SEP 24 1965

CONSERVATION DIVISION  
Wichita, Kansas