


15-199-20008-0000

STATE OF KANSAS
STATE CORPORATION COMMISSION
CONSERVATION DIVISION
P. O. BOX 17027
WICHITA, KANSAS 67217

FORM CP-4

WELL PLUGGING RECORD

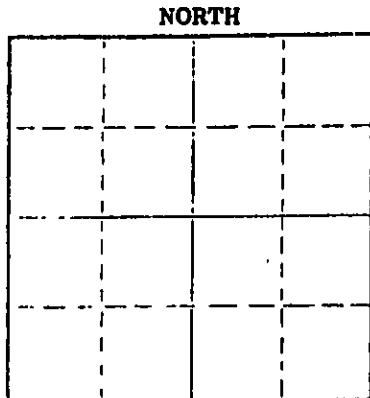

Locate well correctly on above Section Plot

Wallace County, Sec. 18 Twp. 15S Rgs. (E) 42 (W)
Location as "NE/CNW/SE/SW" or footage from lines 660' FN&W Lines
Lease Owner Phillips Petroleum Company
Lease Name Johannes 'A' Well No. 1
Office Address Box 358, Borger, Texas
Character of Well (completed as Oil, Gas or Dry Hole) Dry Hole
Date well completed 6-29 19 75
Application for plugging filed 6-29 19 75
Application for plugging approved 6-29 19 75
Plugging commenced 6-29 19 75
Plugging completed 6-29 19 75
Reason for abandonment of well or producing formation No commercial quantities of oil or gas encountered.
If a producing well is abandoned, date of last production 19
Was permission obtained from the Conservation Division or its agents before plugging was commenced? Yes

Name of Conservation Agent who supervised plugging of this well Gilbert Balthazor
Producing formation _____ Depth to top _____ Bottom _____ Total Depth of Well 5550 Feet
Show depth and thickness of all water, oil and gas formations.

OIL, GAS OR WATER RECORDS

CASING RECORD

FORMATION	CONTENT	FROM	TO	SIZE	PUT IN	PULLED OUT
Surface Hole	Water	Surface	554	8-5/8"	544'	None

Describe in detail the manner in which the well was plugged, indicating where the mud fluid was placed and the method or methods used in introducing it into the hole. If cement or other plugs were used, state the character of same and depth placed, from _____ feet to _____ feet for each plug set.

Fluid to 5100', plug, 50 sx cement;
Fluid to 3150', plug, 50 sx cement;
Fluid to 600', plug, 50 sx cement;
Fluid to 40', plug, 10 sx cement.

RECEIVED
STATE CORPORATION COMMISSION

JUL 9 1975

CONSERVATION DIVISION
Wichita, Kansas

Name of Plugging Contractor (If additional description is necessary, use BACK of this sheet) D N B DRILLING, INC.
Address 701 First National Building
Wichita, Kansas 67202

STATE OF KANSAS COUNTY OF _____

JAMES L. DONELSON (employee of owner) or (owner or operator) of the above-described well, being first duly sworn on oath, says: That I have knowledge of the facts, statements, and matters herein contained and the log of the above-described well as filed and that the same are true and correct. So help me God.

(Signature) James L. Donelson
701 First Nat'l Bldg., Wichita, Kansas
(Address)

Subscribed and Sworn to before me this 8th day of July 19 75

My commission expires August 25, 1976

Ella Priess
Notary Public.

Ella Priess
STATE NOTARY PUBLIC
Sedgewick County, Kansas
My Com. Expires Aug. 25, 1976

15-199-20008-01-00

STATE OF KANSAS
STATE CORPORATION COMMISSION

Form CP-4

Give All Information Completely.
Make Required Affidavit
Mail or Deliver Report to:
Conservation Division
State Corporation Commission
212 No. Market
Wichita, Kansas 67202

WELL PLUGGING RECORD

Wallace County, Sec. 18 Twp. 15 Rge. 42 (E) W (W)

Location as "NE/CNW/SW" or footage from lines 660' FN & WL

Lease Owner Phillips Petroleum Company

Lease Name Johannes "A" Well No. 1

Office Address Box 358

Character of Well (completed as Oil, Gas or Dry Hole) Dry Hole

Date well completed June 28, 1975

Application for plugging filed * June 29, 1975

Application for plugging approved June 29, 1975


Plugging commenced June 29, 1975

Plugging completed June 29, 1975

Reason for abandonment of well or producing formation Dry Hole

If a producing well is abandoned, date of last production NA 19

Was permission obtained from the Conservation Division or its agents before plugging was commenced? Yes

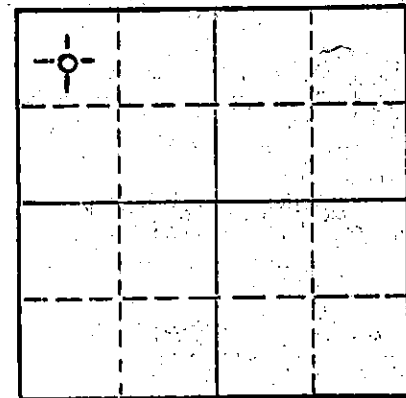

Locate well correctly on above Section Plat

Name of Conservation Agent who supervised plugging of this well Gilbert Balthazor

Producing formation None Depth to top Bottom Total Depth of Well 5550 Feet

Show depth and thickness of all water, oil and gas formations.

OIL, GAS OR WATER RECORDS

CASING RECORD

FORMATION	CONTENT	FROM	TO	SIZE	PUT IN	PULLED OUT
No gas or oil producing formation				8 5/8	545	None

Describe in detail the manner in which the well was plugged, indicating where the mud fluid was placed and the method or methods used in introducing it into the hole. If cement or other plugs were used, state the character of same and depth placed, from feet to feet for each plug set.

Spotted 50 Sxs. Class "H" Cmt. (5000-5100') , 50 Sxs. (3050-3150') , 50 Sxs. (505-605') , and 10 Sxs. (5-35') .

RECEIVED
STATE CORPORATION COMMISSION

JUL 11 1975

CONSERVATION DIVISION
Wichita, Kansas

(If additional description is necessary, use BACK of this sheet)

Name of Plugging Contractor D. N. B. Drilling, Inc.
Address 701 First National Bank Building, Wichita, Kansas 67202

STATE OF Texas, COUNTY OF Hutchinson, ss.
D. R. Weston (employee of owner) or (owner or operator) of the above-described

well, being first duly sworn on oath, says: That I have knowledge of the facts, statements, and matters herein contained and the log of the above-described well as filed and that the same are true and correct. So help me God.

(Signature) D. R. Weston

Box 358, Borger, Texas 79007 (Address)

SUBSCRIBED AND SWORN to before me this 10th day of July, 1975

Sharon E. [Signature] Notary Public.

My commission expires June 1, 1977

* Initial telephone request

15-199-20008-00-00

DRILLERS' LOG

PHILLIPS PETROLEUM COMPANY
Johannes 'A' No. 1
660' FN&W Lines, Sec. 18-15S-42W
Wallace County, Kansas

Commenced: 6-4-75
Completed: 6-29-75

Elevation: 3932 K.B.

Surface Casing: 544' of 8-5/8" cemented w/400 sx class H cement w/28 cc., did not circulate, cemented thru 2" w/100 sx Class H cement w/38 cc. 6-5-75

<u>FORMATION</u>	<u>DEPTH</u>
Surface Hole	0 - 555
Shale & Sand	555 - 665
Dry Drill	665 - 697
Shale	697 - 2000
Lime & Shale	2000 - 2329
Shale	2329 - 2402
Lime & Shale	2402 - 2812
Anhydrite	2812 - 2852
Lime & Shale	2852 - 4245
Lime	4245 - 4550
Lime & Shale	4550 - 4598
Lime	4598 - 4610
Lime & Shale	4610 - 4755
Lime	4755 - 4980
Lime & Sand	4980 - 5037
Lime	5037 - 5550 RTD

RECEIVED
STATE CORPORATION COMMISSION
JUL 9 1975
CONSERVATION DIVISION
Wichita, Kansas

I do hereby certify that the foregoing statements are true and correct to the best of my knowledge and belief.

D N B DRILLING, INC.

James L. Donelson
JAMES L. DONELSON

STATE OF KANSAS: ss:

Subscribed and sworn to before me this 8th day of July, 1975.

My Commission Expires:
August 25, 1976

Ella Priess
Ella Priess, Notary Public

Ella Priess
STATE NOTARY PUBLIC
Sedgwick County, Kansas
My Com. Expires Aug. 25, 1976