


STATE OF KANSAS  
STATE CORPORATION COMMISSION

Give All Information Completely  
Make Required Affidavit  
Mail or Deliver Report to:  
Conservation Division  
State Corporation Commission  
311 No. Broadway  
Wichita, Kansas

WELL PLUGGING RECORD

15-199-00016-00-00

NORTH

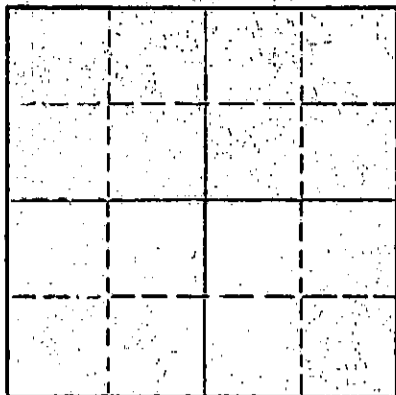

Locate well correctly on above  
Section Plat

Wallace County, Sec. 15 Twp. 15S Rge. 42 (NE) (W)  
Location as "NE/CNW/SW" or footage from lines C NW NW  
Lease Owner Sierra Petroleum Co., Inc.  
Lease Name Myer-Peterson Well No. 1  
Office Address 420 W. Douglas Ave., Wichita, Kansas  
Character of Well (completed as Oil, Gas or Dry Hole) Dry  
Date well completed 12/18/56 19  
Application for plugging filed 12/17/56 19  
Application for plugging approved 12/17/56 19  
Plugging commenced 12/19/56 19  
Plugging completed 12/19/56 19  
Reason for abandonment of well or producing formation Dry

If a producing well is abandoned, date of last production 19  
Was permission obtained from the Conservation Division or its agents before plugging was commenced? yes

Name of Conservation Agent who supervised plugging of this well Eldon Petty  
Producing formation \_\_\_\_\_ Depth to top \_\_\_\_\_ Bottom \_\_\_\_\_ Total Depth of Well 5338 Feet  
Show depth and thickness of all water, oil and gas formations.

OIL, GAS OR WATER RECORDS

CASING RECORD

FORMATION	CONTENT	FROM	TO	SIZE	PUT IN	PULLED OUT
				13 3/8"	422	none

Describe in detail the manner in which the well was plugged, indicating where the mud fluid was placed and the method or methods used in introducing it into the hole. If cement or other plugs were used, state the character of same and depth placed, from \_\_\_\_\_ feet to \_\_\_\_\_ feet for each plug set.

PLUGGING RECORD

Filled hole 5338 up to 415' with heavy mud. Set wood plug @ 415' with 3 sacks hulls and 30 sacks cement through drill pipe up to 385'.  
Filled with heavy mud from 385' up to 20'. Set wood plug at 20' with 1 sack hulls and 20 sack cement to cellar 0  
Job complete 9:30 a.m. 12/19/56

(If additional description is necessary, use BACK of this sheet)  
Name of Plugging Contractor Sierra Petroleum Co., Inc.  
Address 420 W. Douglas Ave., Wichita, Kansas

STATE OF KANSAS COUNTY OF RUSSELL, ss.  
C. I. Honaker (employee of owner) or (owner or operator) of the above-described well, being first duly sworn on oath, says: That I have knowledge of the facts, statements, and matters herein contained and the log of the above-described well as filed and that the same are true and correct. So help me God.

(Signature) C. I. Honaker

(Address)

SUBSCRIBED AND SWORN TO before me this 21st day of Decemern, 19 56

Margie Cooper Notary Public.

My commission expires 1-30-57.

PLUGGING  
20 15 15 42W  
BOOK PAGE 128 LI 22

12-22-56  
CONS. DIV. STATE CORP. COM. WICHITA, KANSAS

Sierra Petroleum Co., Inc.

Myer-Peterson #1  
C NW NW Sec. 15-15S-42W  
Wallace County, Kansas

Elev: 3887 KB  
Total Depth: 5338

Comm: 11/15/56  
Comp: 12/16/56

Casings: cement  
13 3/8" @ 422' with 400 sacks.

FORMATION	DEPTH
Post Rock, Gravel & sand	170
Sand	429
Shale & Bentonite	778
Shale	1060
Shale & Lime	1150
Shale	1520
Shale & lime	1660
Lime	1930
Lime & shale	2035
Green shale & lime	2050
Shale & lime	2198
Lime	2318
Lime & shale	2340
Shale & red bed	2638
Lime & shale	2645
Shale & red bed	2811
Lime & shale	2835
Red Shale	2850
Anhydrite	2885
Lime & shale	3167
Lime	3171
Lime & sand	3177
Lime & shale	3540
Lime	3787
Lime & shale	3863
Lime	5096
Shale & lime	5338
Tops: Anhydrite	2850
Lansing K. C.	4222
Mississippi	5225

STATE OF KANSAS )  
                          ) ss:  
COUNTY OF RUSSELL )

I hereby certify that the above information is true and correct to the best of my knowledge.

C. P. Henaker

Subscribed and sworn to before me this 21st day of December, 1956.

Margie Cooper  
Notary Public

My commission expires: 1-30-57.

15 15 42W  
128 2