


WELL PLUGGING RECORD

Give All Information Completely
Make Required Affidavit
Mail or Deliver Report to:
Conservation Division
State Corporation Commission
211 No. Broadway
Wichita, Kansas

Wallace County, Sec. 7 Twp 15S Rge 42 (E) W (W)

Location as "NE/CNW/SW" or footage from lines C SW SW
Lease Owner Phillips Petroleum Co.
Lease Name Elaso Well No. 1
Office Address Bartlesville, Oklahoma
Character of Well (completed as Oil, Gas or Dry Hole) Dry hole
Date well completed 4-13 1959
Application for plugging filed 4-14-59 - Big Phone 1959
Application for plugging approved 4-14 1959
Plugging commenced 10 AM 4-14-59 1959
Plugging completed 2:30 PM 4-14 1959
Reason for abandonment of well or producing formation _____

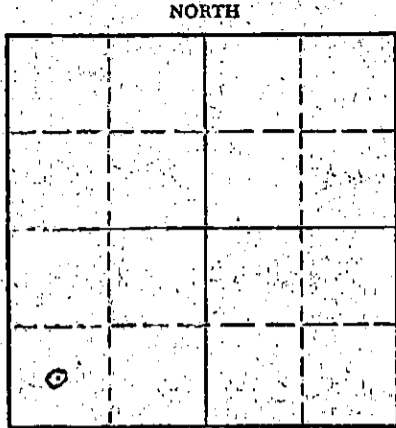

Locate well correctly on above Section Plat

If a producing well is abandoned, date of last production _____ 19____
Was permission obtained from the Conservation Division or its agents before plugging was commenced? Yes Gilbert P. Heiker

Name of Conservation Agent who supervised plugging of this well Gilbert P. Heiker
Producing formation _____ Depth to top _____ Bottom _____ Total Depth of Well 5760 Feet
Show depth and thickness of all water, oil and gas formations.

OIL, GAS OR WATER RECORDS

CASING RECORD

FORMATION	CONTENT	FROM	TO	SIZE	PUT IN	PULLED OUT
		<u>0</u>	<u>600</u>	<u>8" 10"</u>	<u>✓</u>	<u>No</u>

Describe in detail the manner in which the well was plugged, indicating where the mud fluid was placed and the method or methods used in introducing it into the hole. If cement or other plugs were used, state the character of same and depth placed, from _____ feet to _____ feet for each plug set.

Pits were grouted & Heavy Mud pumped into hole through open end pipe. 45 sacks of cement was placed from 5372' to 5172' - Pulled up the hole and 45 sacks of cement was placed from 5050' to 4850'.
Pipe was lugged down to 670' - and then hole was filled with Heavy Mud and circulated. 25 sacks of cement was placed from 670' to 560' - This plug being 70' below the casing to 40' into the casing.
Ten sacks of cement at surface.

07-20-59

Name of Plugging Contractor Halliburton Oil Well Cementing Co.
Address Hill City, Kansas

STATE OF _____ COUNTY OF _____ ss. _____ (employee of owner) or (owner or operator) of the above-described well, being first duly sworn on oath, says: That I have knowledge of the facts, statements, and matters herein contained and the log of the above-described well as filed and that the same are true and correct. So help me God.

(Signature) J. H. Smith
Madison, Kansas
(Address)

SUBSCRIBED AND SWORN TO before me this 18th day of July 1959
William M. Krawls
Notary Public.

My commission expires Jan 18 - 1960

PLUGGING
FILE SEC. 7 T. 15 R. 42
BOOK PAGE 43 LINE 00