


WELL PLUGGING RECORD

Give All Information Completely
Make Required Affidavit
Mail or Deliver Report to
Conservation Division
State Corporation Commission
211 No. Broadway
Wichita, Kansas

NORTH

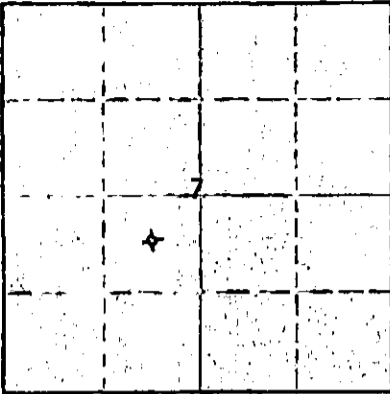

Locate well correctly on above
Section Plot

Greeley County, Sec. 7 Twp. 16S Rge. (E) 40 (W)
Location as "NE/CNW&SW.4" or footage from lines. C NE/4 SW/4
Lease Owner Graham-Michaelis Drilling, Inc.
Lease Name Rinck Well No. 1-7
Office Address 211 North Broadway, Wichita, Kansas 67202
Character of Well (completed as Oil, Gas or Dry Hole) Dry Hole
Date well completed April 6, 19 67
Application for plugging filed April 7, 19 67
Application for plugging approved (verbal) April 6, 19 67
Plugging commenced April 6, 19 67
Plugging completed April 6, 19 67
Reason for abandonment of well or producing formation

If a producing well is abandoned, date of last production 19
Was permission obtained from the Conservation Division or its agents before plugging was commenced? Yes

Name of Conservation Agent who supervised plugging of this well W. L. Nichols, Moreland, Kansas
Producing formation Depth to top Bottom Total Depth of Well 5388 Feet
Show depth and thickness of all water, oil and gas formations.

OIL, GAS OR WATER RECORDS

CASING RECORD

FORMATION	CONTENT	FROM	TO	SIZE	PUT IN	PULLED OUT
				8 5/8"	350	none

Describe in detail the manner in which the well was plugged, indicating where the mud fluid was placed and the method or methods used in introducing it into the hole. If cement or other plugs were used, state the character of same and depth placed, from feet to feet for each plug set.

Plugged with 25 sacks cement at 660', filled with heavy drilling mud, 25 sacks cement at 360', filled with heavy drilling mud, 10 sacks cement to top of surface casing.

APR 13 1967
04-13-1967
WICHITA, KANSAS
CONSERVATION DIVISION

(If additional description is necessary, use BACK of this sheet)

Name of Plugging Contractor Graham-Michaelis Drilling, Inc.
Address 211 North Broadway, Wichita, Kansas 67202

STATE OF Kansas, COUNTY OF Sedgwick, ss.
Jack L. Yinger (employee of owner) of the above-described well, being first duly sworn on oath, says: That I have knowledge of the facts, statements, and matters herein contained and the log of the above-described well as filed and that the same are true and correct. So help me God.

(Signature) Jack L. Yinger
211 North Broadway, Wichita, Kansas 67202
(Address)

SUBSCRIBED AND SWORN TO before me this 10th day of April, 19 67

Evelyn D. Evans
Evelyn D. Evans Notary Public.

15-071-20001-00-00

RINCK NO. 1-7

WELL RECORD:

LOCATION:

C NE SW Section 7-16S-40W
Greeley County, Kansas

Commenced: 3-23-67
Completed: 4-7-67
(Rotary)

CONTRACTOR:

Graham-Michaelis Drilling, Inc.
Liberal Division
P. O. Box 1294
Liberal, Kansas 67901

CASING RECORD:

11 Joints 8-5/8" 24# Casing set
at 349' w/250 sx Sunset

	<u>LOG</u>	
Surface Sand	0 -	165
Sand, Red Bed & Shale	165 -	1744
Lime & Shale	1744 -	2117
Red Bed & Anhy Streaks	2117 -	2617
Red Bed, Anhy, Shale & Lime	2617 -	2872
Lime & Shale	2872 -	4874
Lime	4874 -	4926
Lime & Shale	4926 -	5036
Sand & Lime	5036 -	5093
Lime & Shale	5093 -	5121
Lime	5121 -	5207
Lime & Shale	5207 -	5227
Lime	5227 -	5260
Lime, Chert & Shale	5260 -	5346
Chert, Pyrite, Lime & Shale	5346 -	5388

RECEIVED
STATE CORPORATION COMMISSION
APR 13 1967
04-13-1967
CONSERVATION DIVISION
Wichita, Kansas

5388' - Total Rotary Depth

The undersigned, Graham-Michaelis Drilling, Inc., Liberal Division, certifies that the above log is a true and correct copy of the formations encountered in drilling the above mentioned well, as taken from the Daily Drilling Report.

GRAHAM-MICHAELIS DRILLING, INC.
LIBERAL DIVISION

By 
H. R. Michaelis

HRM/rw