

15-071-20282-00-00


STATE OF KANSAS
STATE CORPORATION COMMISSION

Form CP-4

Give All Information Completely
Make Required Affidavit
Mail or Deliver Report to:
Conservation Division
State Corporation Commission
P. O. Box 17027
Wichita, Kansas 67217
NORTH

Rec. 12-05-1983

WELL PLUGGING RECORD

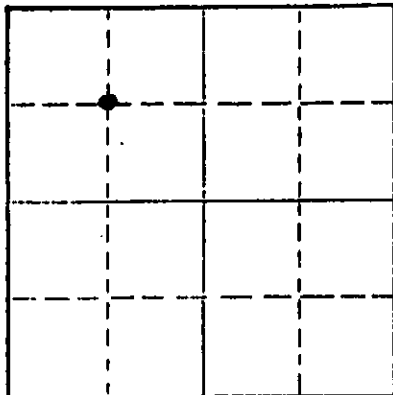

Locate well correctly on above
Section Plat

Greeley County, Sec 32 Twp 16S Rge 39 (X) X (W)
Location as "NE/CNW/SW" or footage from lines C NW/4
Lease Owner Bartling Oil Company
Lease Name Price Well No. 2
Office Address 8550 Katy Freeway, Ste. 128, Houston, TX 77024
Character of Well (completed as Oil, Gas or Dry Hole) Gas - non commercial
Date well completed December 22, 1982 19
Application for plugging filed November 28 19 83
Application for plugging approved December 8 19 83
Plugging commenced December 13 19 83
Plugging completed December 13 19 83
Reason for abandonment of well or producing formation non-commercial

If a producing well is abandoned, date of last production None 19
Was permission obtained from the Conservation Division or its agents before plugging was commenced? Yes

Name of Conservation Agent who supervised plugging of this well Paul Luthi
Producing formation Chase Depth to top 2924 Bottom 3010 Total Depth of Well 3070 Feet
Show depth and thickness of all water, oil and gas formations.

OIL, GAS OR WATER RECORDS

CASING RECORD

FORMATION	CONTENT	FROM	TO	SIZE	PUT IN	PULLED OUT
Upper Winfield	water	2924	2940	8-5/8"	293'	None
Lower Winfield	water	2940	3010	4-1/2"	3068'	None

Describe in detail the manner in which the well was plugged, indicating where the mud fluid was placed and the method or methods used in introducing it into the hole. If cement or other plugs were used, state the character of same and depth placed, from _____ feet to _____ feet for each plug set.

RU Howco - pumped down casing 25 sx 60/40 Pozmix mixed w/1 sx cottonseed hulls w/ 2% gel & 3% CaCl followed by 10 sx gel plus 125 sx 60/40 Pozmix w/ 2% gel & 3% CaCl. SI 600#. Supervised by Paul Luthi - Kansas Corporation Commission Field Plugging Representative.

(If additional description is necessary, use BACK of this sheet)

Name of Plugging Contractor Halliburton
Address Lamar, Colorado

STATE OF Kansas COUNTY OF Seward ss.
R.L. Higginbottom (employee of owner) or (owner or operator) of the above-described

well, being first duly sworn on oath, says: That I have knowledge of the facts, statements, and matters herein contained and the log of the above-described well as filed and that the same are true and correct. So help me God.

(Signature) [Signature]
P.O. Box 6, Liberal, KS 67901
(Address)

Subscribed and Sworn to before me this 20th day of December 19 83

My commission expires
NOTARY PUBLIC - State of Kansas
A. J. PARNELL
My Appt. Exp. 7-7-85

[Signature]
Notary Public.