

CARD MUST BE TYPED

State of Kansas

CARD MUST BE SIGNED

NOTICE OF INTENTION TO DRILL

(see rules on reverse side)

Starting Date 3 15 86 month day year 2:32

API Number 15- 199-20,079-00-00

OPERATOR: License # 5171
Name TXO Production Corp.
Address 155 N. Market Suite 1000
City/State/Zip Wichita, KS 67202
Contact Person Jerry W. Collins
Phone 316-269-7600

Approx. SW/4 Sec. 25 Twp. 15 S, Rg. 41 West
1100 Ft. from South Line of Section
2370 Ft. from East Line of Section

(Note: Locate well on Section Plat on reverse side)

CONTRACTOR: License # 6033
Name Murfin Drilling Company
City/State Wichita, KS

Nearest lease or unit boundary line 330 feet
County Wallace

Lease Name AKERS "C" Well # 1

Ground surface elevation TBD feet MSL

Well Drilled For: Well Class: Type Equipment:
X Oil SWD Infield Mud Rotary
Gas Inj Pool Ext Air Rotary
OWWO Expl Wildcat Cable

Domestic well within 330 feet: yes X no

Municipal well within one mile: yes X no

Depth to bottom of fresh water 150

Depth to bottom of usable water 1700

Surface pipe by Alternate: 1 2 X

Surface pipe planned to be set 450

Conductor pipe required 0

Projected Total Depth 5400 feet

Formation Mississippian Spergen

If OWWO: old well info as follows:

Operator
Well Name
Comp Date Old Total Depth

I certify that well will comply with K.S.A. 55-101, et seq., plus eventually plugging hole to KCC specifications.

Date 3-5-86 Signature of Operator or Agent Jeffrey S. Collins Title Drilling Engineer

For KCC Use:

Conductor Pipe Required 7 feet; Minimum Surface Pipe Required 250 feet per Alt. 40

This Authorization Expires 7-13-86 Approved By 3-13-86

Base Chex. 12000


Handwritten signature

Must be filed with the K.C.C. five (5) days prior to commencing well
This card void if drilling not started within six (6) months of date received by K.C.C.

Important procedures to follow:

1. Notify District office before setting surface casing.
2. Set surface casing by circulating cement to the top.
3. File completion forms ACO-1 with K.C.C. within 90 days of well completion, following instructions on ACO-1, side 1, and including copies of wireline logs.
4. Notify District office 48 hours prior to old well workover or re-entry.
5. Prior to filing Intent, prepare a proposed plugging plan in case well is D & A, then obtain approval of plan when calling district office prior to setting surface pipe.
6. Submit plugging report (CP-4) to K.C.C. after plugging is completed.
7. Obtain an approved injection docket number before disposing of salt water.
8. Notify K.C.C. within 10 days when injection commences or terminates.
9. If an alternate 2 completion, cement in the production pipe from below any usable water to surface within 120 days of spud date.

A Regular Section of Land
1 Mile = 5,280 Ft.

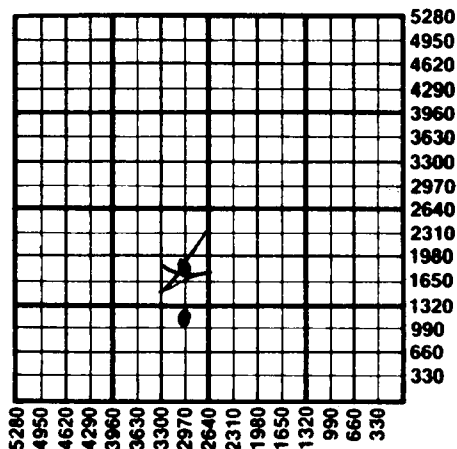

RECEIVED
STATE CORPORATION COMMISSION
03-13-86

MAR 13 1986

CONSERVATION DIVISION

RECEIVED Corporation Commission of Kansas
STATE CORPORATION COMMISSION Division
200 Colorado Derby Building

Wichita, Kansas 67202

MAR 13 1986 (316) 263-3238