

CARD MUST BE TYPED

State of Kansas
NOTICE OF INTENTION TO DRILL
(see rules on reverse side)

CARD MUST BE SIGNED

Starting Date: 08 13 1984
month day year 4:29

API Number 15- 171-20,281-0000

OPERATOR: License # 6113
Name Landmark Oil Exploration, Inc.
Address 105 S. Broadway, Suite 1040
City/State/Zip Wichita, Kansas 67202
Contact Person Mel Hussey
Phone (316) 265-8181

150' NE of C S/2 NE/4 7 Twp 20 S, Rge 33 .. East
(location) Sec West

..... 3400 ... Ft North from Southeast Corner of Section
..... 1220 ... Ft West from Southeast Corner of Section
(Note: Locate well on Section Plat on reverse side)

CONTRACTOR: License # 6033
Name Murfin Drilling
City/State Wichita, Kansas 67202

Nearest lease or unit boundary line 765 feet.
County Scott
Lease Name Carr Well# 2-7

Well Drilled For: Well Class: Type Equipment:
 Oil Swd Infield Mud Rotary
 Gas Inj Pool Ext. Air Rotary
 OWWO Expl Wildcat Cable

Domestic well within 330 feet: yes no
Municipal well within one mile: yes no

If OWWO: old well info as follows:

Operator
Well Name
Comp Date Old Total Depth
Projected Total Depth 4750 feet
Projected Formation at TD Mississippi
Expected Producing Formations Morrow

Depth to Bottom of fresh water 115-170^{W HC} feet
Lowest usable water formation Dakota Sandstone
Depth to Bottom of usable water 1000 feet
Surface pipe by Alternate: 1 2
Surface pipe to be set 400 feet
Conductor pipe if any required None feet
Ground surface elevation feet MSL
This Authorization Expires 2-9-85
Approved By *[Signature]*

I certify that we will comply with K.S.A. 55-101, et seq., plus eventually plugging hole to K.C.C. specifications.

Date 8-9-84 Signature of Operator or Agent

[Signature] Title Exploration Manager
Merlin C. Hussey

W HC / DONE 8/9/84


Must be filed with the K.C.C. five (5) days prior to commencing well
 This card void if drilling not started within six (6) months of date received by K.C.C.

RECEIVED
 STATE CORPORATION COMMISSION

JURISDICTION DIVISION
 Wichita, Kansas
 AUG 9 1984
 8-9-84

Important procedures to follow

**A Regular Section of Land
 1 Mile = 5,280 Ft.**

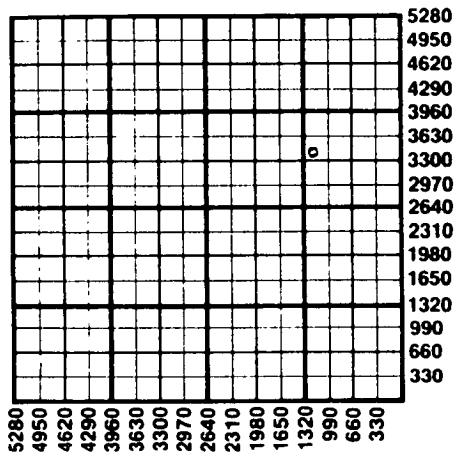

1. Notify District office before setting surface casing
2. Set surface casing by circulating cement to the top.
3. File completion forms ACO-1 with K.C.C. within 90 days of well completion, following instructions on ACO-1, side 1, and including copies of wireline logs.
4. Notify District office 48 hours prior to old well workover or re-entry.
5. Prior to plugging, prepare a plugging plan, then obtain agreement from the appropriate district office for an approved plugging plan.
6. Submit plugging report (CP-4) to K.C.C. after plugging is completed.
7. Obtain an approved injection docket number before disposing of salt water.
8. Notify K.C.C. within 10 days when injection commences or terminates.
9. If an alternate 2 completion, cement in the production pipe from below any usable water to surface within 120 days of spud date.

State Corporation Commission of Kansas
 Conservation Division
 200 Colorado Derby Building
 Wichita, Kansas 67202
 (316) 263-3238