

CARD MUST BE TYPED

State of Kansas  
**NOTICE OF INTENTION TO DRILL**  
(see rules on reverse side)

CARD MUST BE SIGNED

Starting Date: April 30, 1985  
month day year

API Number 15- 171-10,292-0000

OPERATOR: License # 5210

C NW SE Sec 5 Twp 20 S, Rge 33  East  West  
(location)

Name Lebsack Oil Production, Inc.

Address Box 489

City/State/Zip Hays, Kansas 67601

Contact Person Wayne Lebsack

Phone 316-938-2396

1980 Ft North from Southeast Corner of Section

1980 Ft West from Southeast Corner of Section

(Note: Locate well on Section Plat on reverse side)

CONTRACTOR: License # 5422

Name Abercrombie Drilling Inc.

City/State 801 Union Center - Wichita, Ks.

Nearest lease or unit boundary line 1980 feet.

County Scott

Lease Name Hattendorf Well# 4

Well Drilled For: Well Class: Type Equipment:

- Oil  Swd  Infield  Mud Rotary
- Gas  Inj  Pool Ext.  Air Rotary
- OWWO  Expl  Wildcat  Cable

Domestic well within 330 feet:  yes  no

Municipal well within one mile:  yes  no

If OWWO: old well info as follows:

Depth to Bottom of fresh water 200 feet

Lowest usable water formation Dakota

Depth to Bottom of usable water 1000 feet

Surface pipe by Alternate: 1  2

Surface pipe to be set 400 feet

Conductor pipe if any required \_\_\_\_\_ feet

Ground surface elevation 2985 feet MSL

This Authorization Expires 10-17-85

Approved By 9-17-85 *[Signature]*

I certify that we will comply with K.S.A. 55-101, et seq., plus eventually plugging hole to K.C.C. specifications.

Date 4-16-85 Signature of Operator or Agent

*[Signature: Rex Curtis]*  
Rex Curtis


Title \_\_\_\_\_

*MHC/NOHE 4-17-85*

Must be filed with the K.C.C. five (5) days prior to commencing well  
This card void if drilling not started within six (6) months of date received by K.C.C.

RECEIVED  
STATE CORPORATION COMMISSION

A Regular Section of Land  
1 Mile = 5,280 Ft.

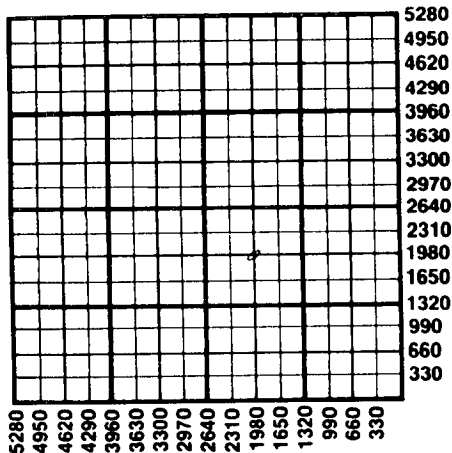

Important procedures to follow

1. Notify District office before setting surface casing.
2. Set surface casing by circulating cement to the top.
3. File completion forms ACO-1 with K.C.C. within 90 days of well completion, following instructions on ACO-1, side 1, and including copies of wireline logs.
4. Notify District office 48 hours prior to old well workover or re-entry.
5. Prior to plugging, prepare a plugging plan, then obtain agreement from the appropriate district office for an approved plugging plan.
6. Submit plugging report (CP-4) to K.C.C. after plugging is completed.
7. Obtain an approved injection docket number before disposing of salt water.
8. Notify K.C.C. within 10 days when injection commences or terminates.
9. If an alternate 2 completion, cement in the production pipe from below any usable water to surface within 120 days of spud date.

APR 17 1985  
4-17-85  
CONSERVATION DIVISION  
Wichita, Kansas

State Corporation Commission of Kansas  
Conservation Division  
200 Colorado Derby Building  
Wichita, Kansas 67202  
(316) 263-3238