


WELL PLUGGING RECORD

Give All Information Completely  
Make Required Affidavit  
Mail or Deliver Report to:  
Conservation Division  
State Corporation Commission  
800 Bitting Building  
Wichita, Kansas

NORTH

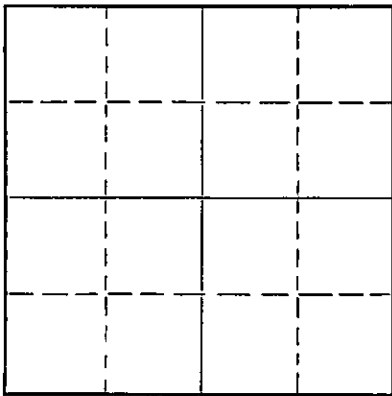

Locate well correctly on above  
Section Flat

Wallace County, County. Sec. 18 Twp. 15 Rge. 41 (E) W. (W)  
Location as "NE/CNW $\frac{1}{4}$ /SW $\frac{1}{4}$ " or footage from lines C NW/4 SE/4  
Lease Owner Phillips Petroleum Co.  
Lease Name D. Westerbeerg Well No. 1  
Office Address Bartlesville, Okla.  
Character of Well (completed as Oil, Gas or Dry Hole) Dry Hole  
Date well completed May 15, 1959  
Application for plugging filed May 15 1959  
Application for plugging approved By Phone May 15 1959  
Plugging commenced 10 AM May 15 1959  
Plugging completed May 15 1959  
Reason for abandonment of well or producing formation Dry Hole

If a producing well is abandoned, date of last production 19  
Was permission obtained from the Conservation Division or its agents before plugging was commenced? Yes

Name of Conservation Agent who supervised plugging of this well Gilbert P. Leiker  
Producing formation Depth to top Bottom Total Depth of Well 5417 Feet  
Show depth and thickness of all water, oil and gas formations.

OIL, GAS OR WATER RECORDS

CASING RECORD

Formation	Content	From	To	Size	Put In	Pulled Out

REC.  
STATE CORPORATION COMMISSION  
JUL 20 1959  
CONSERVATION DIVISION  
Wichita, Kansas

Describe in detail the manner in which the well was plugged, indicating where the mud fluid was placed and the method or methods used in introducing it into the hole. If cement or other plugs were used, state the character of same and depth placed, from... feet to... feet for each plug set.

Open and pipe was run into hole and  
30 sacks of cement was run from 650' to 550'  
25 sacks of cement was run from 300' to 200'  
10 sacks of cement was run at surface.

Heavy mud was pumped into the hole and  
shells were put on top of plug at surface.

(If additional description is necessary, use BACK of this sheet)

Correspondence regarding this well should be addressed to  
Address MR. Lehman Wichita, Kansas.

STATE OF \_\_\_\_\_, COUNTY OF \_\_\_\_\_, ss.

\_\_\_\_\_ (employee of owner) or (owner or operator) of the above-described well,  
being first duly sworn on oath, says: That I have knowledge of the facts, statements, and matters herein contained and the log of the above-described well as filed and that the same are true and correct. So help me God.

(Signature) E. G. Smith  
Bartlesville, Kansas (Address)

SUBSCRIBED AND SWORN TO before me this 18<sup>th</sup> day of July, 1959  
Hulma M. Thudson  
Notary Public.

My commission expires June 15 - 1960

PLUGGING  
FILE SEC. 18 T. 15 R. 41  
BOOK PAGE 52 LINE 12