

15-199-00027-00-00

WELL PLUGGING RECORD

Give All Information Completely  
Make Required Affidavit  
Mail or Deliver Report to:  
Conservation Division  
State Corporation Commission  
800 Bittling Building  
Wichita, Kansas

Wallace County, Sec. 13 Twp. 14S Rge. 42W (E) (W)

Location as "NE/CNW/SW" or footage from lines CNW NW

Lease Owner United Producing Co., Inc.

Lease Name M. A. Fitzgerald Well No. 1

Office Address Drawer 30 - Liberal, Kansas

Character of Well (completed as Oil, Gas or Dry Hole) Dry Hole

Date well completed 5-22- 19 55

Application for plugging filed 6-7- 19 55

Application for plugging approved 6-9- 19 55


Plugging commenced August 20 19 55

Plugging completed August 22 19 55

Reason for abandonment of well or producing formation \_\_\_\_\_

If a producing well is abandoned, date of last production \_\_\_\_\_ 19 \_\_\_\_\_

Was permission obtained from the Conservation Division or its agents before plugging was commenced? Yes

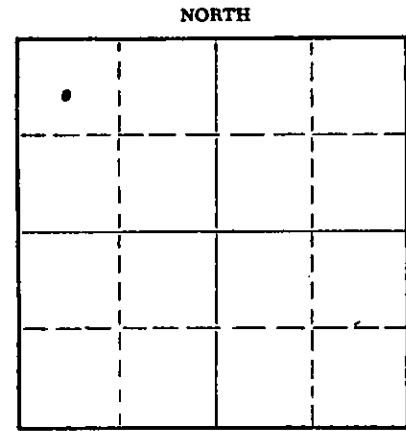

Locate well correctly on above Section Flat

Name of Conservation Agent who supervised plugging of this well Warren H. Horner

Producing formation \_\_\_\_\_ Depth to top \_\_\_\_\_ Bottom \_\_\_\_\_ Total Depth of Well 5150 Feet

Show depth and thickness of all water, oil and gas formations.

OIL, GAS OR WATER RECORDS

CASING RECORD

FORMATION	CONTENT	FROM	TO	SIZE	PUT IN	PULLED OUT
Sand and shale	Fresh water	0	300'	8-5/8"	3112'	1009'
Chase series	Salt Mass.	300'	450'	13-3/8"	500'	None

Describe in detail the manner in which the well was plugged, indicating where the mud fluid was placed and the method or methods used in introducing it into the hole. If cement or other plugs were used, state the character of same and depth placed, from \_\_\_\_\_ feet to \_\_\_\_\_ feet for each plug set.

Filled the hole with mud from 5150' to 2300', set a rock bridge and ran 5 sacks of cement. Mudded the hole to 500', set a rock bridge and ran 25 sacks of cement at 490'. Mudded the hole to 25', set a rock bridge and ran 15 sacks of cement to fill to base of cellar. Plugging completed.

(If additional description is necessary, use BACK of this sheet)

Name of Plugging Contractor West Supply Co., Inc.

Address Chase, Kansas

STATE OF Kansas COUNTY OF Seward, ss.

A. H. Pannell (employee of owner) or (owner or operator) of the above-described well, being first duly sworn on oath, says: That I have knowledge of the facts, statements, and matters herein contained and the log of the above-described well as filed and that the same are true and correct. So help me God.

(Signature) A. H. Pannell A. H. Pannells,

United Producing Company, Inc. Prod. Supt.

SUBSCRIBED AND SWORN TO before me this 30th day of August, 1955

My commission expires April 16, 1956

Gene Marie Street Notary Public.

**PLUGGING**  
FILE SEC 13 T. 14 R. 42W  
BOOK PAGE 125 LINE 23

RECEIVED  
STATE CORPORATION COMMISSION  
AUG 21 1955  
08-31-1955  
CONSERVATION DIVISION  
Wichita, Kansas

15-199-00027-00-00

UNITED PRODUCING COMPANY  
 Your : M.A. Fitzgerald #1  
 Center of NW/4 of NW/4 of  
 Section 13, T-14S-Rge.42W,  
 Wallace County, Kansas

PARKER DRILLING COMPANY

TULSA, OKLAHOMA

FROM	TO	FORMATION	FROM	TO	FORMATION
0	200	Surface Clay Sand	4950	5003	Lime & Shale
	235	Sand		5039	Shale, Lime & 10% Chert
	250	Clay		5104	Sh. Li. & Chert
	300	Sand		5157	Sh. Sd. & Chert
	210	Red Shale		5313	Shale & Lime
	314	Black Shale-Hard		5350	Shale, Lime-25% Chert TD
	435	Black Shale			
	505	Black & Blue Shale			
	451	Shale & Anhy.			
	987	Shale, Lime & Shale			
	1276	Shale & Lime			
	1460	Shale & Sand			
	1504	Lime & Shale			
	1588	Shale & Sand			
	1645	Blk. shale & sand			
	1914	Shale & Sand			
	1984	Shale			
	2025	Quartz-Sand-White			
	2065	Shale			
	2144	Lime & Shale			
	2232	Gyp & Shale			
	2240	Shale-Black			
	2252	Lime-Dolomite			
	2285	Blue Shale-Pyrite-Anhy.			
	2332	Red Shale			
	2424	Lime & Shale			
	2624	Anhy. Lime & Shale			
	2679	Shale & Lime			
	2737	Shale & Lime			
	2801	Anhy. Lime & Shale			
	2814	Shale & Anhy.			
	2834	Shale			
	2869	Lime, Sd. & Anhy.			
	2911	Shale			
	2960	Shale, Anhy. Sdy. Shale			
	3138	Shale & Anhy.			
	3140	Dolomite			
	3182	Dolomite & Anhy.			
	3233	Shale & Dolomite			
	3395	Sd. Shale & Lime			
	3450	Lime Shale Breaks			
	3500	Sandy Shale			
	3520	Anhy. & Dolo.			
	3531	Lime & Shale			
	3598	Dolo. Lime, Shale			
	3879	Lime Chert, Dolo.			
4120	4120	Lime & Shale			
	4145	Grey Lime & Brn. Chert			
	4179	Lime & Blk Shale			
	4400	Lime			
	4443	Lime & Shale			
	4501	Lime & Sand			
	4582	Lime			
	4603	Shale, Sand & Lime			
	4634	Lime & Chert			
	4645	Lime & Chert			
	4887	Lime & Shale			
	4950	Lime, Shale, Chert			

PARKER DRILLING COMPANY

by R. L. Parker  
 President.

RECEIVED  
 STATE COMMISSION  
 JUN 9 1955  
 CONSERVATION DIVISION

PLUGGING  
 WELL SEC 13 T 14 R 42W  
 BOOK PAGE 125 LINE 23