


STATE OF KANSAS  
STATE CORPORATION COMMISSION  
CONSERVATION DIVISION  
P. O. BOX 17027  
WICHITA, KANSAS 67217

FORM CP-4

WELL PLUGGING RECORD

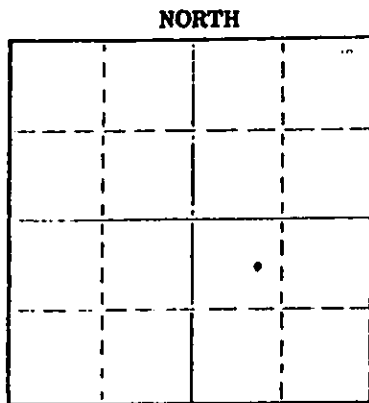

Locate well correctly on above Section Plot

Ellsworth County, Sec 17 Twp 14 Rge (E) 10 (W)  
Location as "NE/CNW/SW" or footage from lines: Approx. E/2 NW SE.  
Lease Owner: L. G. Stephenson & Co.  
Lease Name: Svava Well No. 1  
Office Address: 340 Farm Credit Banks Bldg., Wichita, Kansas  
Character of Well (completed as Oil, Gas or Dry Hole): oil 67202  
Date well completed: Dec. 31 1971  
Application for plugging filed: Feb. 10 1975  
Application for plugging approved: 1975  
Plugging commenced: March 19 1975  
Plugging completed: March 24 1975  
Reason for abandonment of well or producing formation: depleted

If a producing well is abandoned, date of last production: 1975  
Was permission obtained from the Conservation Division or its agents before plugging was commenced? YES

Name of Conservation Agent who supervised plugging of this well: Gilbert Toman  
Producing formation: Depth to top: Bottom: Total Depth of Well: 2895 feet  
Show depth and darkness of all water, oil and gas formations.

OIL, GAS OR WATER RECORDS

CASING RECORD

FORMATION	CONTENT	FROM	TO	SIZE	PUT IN	PULLED OUT
	RECEIVED		244'	8 5/8"	244'	none
STATE CORPORATION COMMISSION			2296'	4 1/2"	2296'	1802.63
	03-27-75					
CONSERVATION DIVISION						
Wichita, Kansas						

Describe in detail the manner in which the well was plugged, indicating where the mud fluid was placed and the method or methods used in introducing it into the hole. If cement or other plugs were used, state the character of same and depth placed, from feet to feet for each plug set.

Sanded back to 2100' and dumped 3 sacks of cement.

Allied Cementing Company plugged well pumping in 3 sacks of hulls, 20 sacks of gel and 85 sacks of cement.

Name of Plugging Contractor: PIPE PULLERS, INC.  
Address: Box 128, Ellinwood, Kansas 67526

STATE OF KANSAS COUNTY OF BARTON ss.  
Evelyn Roth (employee of owner) or (owner or operator) of the above-described

well, being first duly sworn on oath, says: That I have knowledge of the facts, statements, and matters herein contained and the log of the above-described well as filed and that the same are true and correct. So help me God.

(Signature) Evelyn Roth  
Ellinwood, Kansas

Subscribed and sworn to before me this 25th day of March 1975

My commission expires

JENNY KASSELMAN  
NOTARY PUBLIC  
BARTON COUNTY, KANSAS  
MY COMM. EXP. JULY 16, 1978

Jenny Kasselmann  
Notary Public

15-053-20229-00-00

DRILLERS LOG

No. 1 Svava

**CASING RECORD:**

**COMPANY:** Bell Oil Company

**DESCRIPTION:**

8 5/8" @ 244'  
w/170 sx cement

**CONTRACTOR:** Red Tiger Drilling Company

Apk. E/2 NW SE  
17-14S-10W

4 1/2" @ 2290'  
w/100 sx cement

**COMMENCED:** December 22, 1971

Ellsworth County,  
Kansas

**COMPLETED:** December 31, 1971

**TOTAL DEPTH:** 2895'

**ELEVATION:**


<u>FORMATION</u>	<u>FROM</u>	<u>TO</u>	<u>REMARKS</u>
Clay, Sand & Shale	0	250	
Hard Sand & Shale	250	549	
Anhydrite	549	578	
Shale	578	1215	
Shale & Lime	1215	1380	
Shale w/Shells	1380	1590	
Lime & Shale	1590	2480	
Lime	2480	2605	
Lime & Shale	2605	2675	
Lime	2675	2895	

I certify that this is a true and correct copy of the above log to the best of my knowledge.

RED TIGER DRILLING COMPANY

*Jim Farrice*  
Jim Farrice

Subscribed and sworn to before me this 31st day of December, 1971.

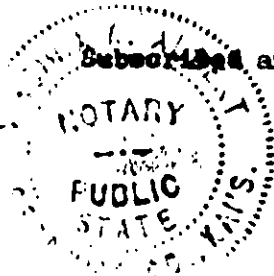

*Virginia K. Albert*  
Notary Public

My Commission Expires: July 23, 1974

RECEIVED  
STATE CORPORATION COMMISSION

DEC 11 1975

CONSERVATION DIVISION  
Wichita, Kansas