


STATE OF KANSAS
STATE CORPORATION COMMISSION

WELL PLUGGING RECORD

Give All Information Completely
Make Required Affidavit
Mail or Deliver Report to
Conservation Division
State Corporation Comm.
245 North Water
Wichita, KS 67202

Pratt County, Sec. 12 Twp. 27S Rge. 13W E/W
Location as "NE/CNW $\frac{1}{4}$ SW $\frac{1}{4}$ " or footage from lines
NE NW NW

Lease Owner Dunne Equities, Inc.
Lease Name Beck Well No. 8
Office Address Suite 140, 260 North Rock Road, Wichita, KS
Character of Well (Completed as Oil, Gas or Dry Hole) Dry hole

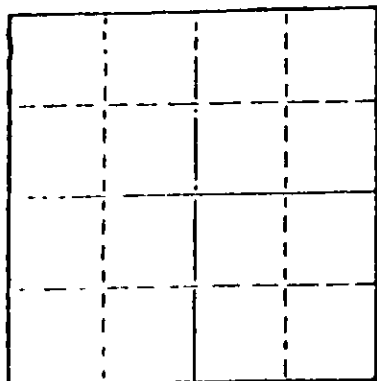

Locate well correctly on above
Section Plat

Date Well completed May 22, 1979
Application for plugging filed May 22, 1979
Application for plugging approved May 22, 1979
Plugging commenced May 22, 1979
Plugging completed May 22, 1979
Reason for abandonment of well or producing formation Dry hole

If a producing well is abandoned, date of last production 19

Was permission obtained from the Conservation Division or its agents before plugging was commenced? yes

Name of Conservation Agent who supervised plugging of this well Bill Owens
Producing formation Depth to top Bottom Total Depth of Well 4290'
Show depth and thickness of all water, oil and gas formations.

OIL, GAS OR WATER RECORDS

CASING RECORD

FORMATION	CONTENT	FROM	TO	SIZE	PUT IN	PULLED OUT
				8-5/8"	412'	--

Describe in detail the manner in which the well was plugged, indicating where the mud fluid was placed and the method or methods used in introducing it into the hold. If cement or other plugs were used, state the character of same and depth placed, from feet to feet for each plug set.

Mud to 600', 50 sx cement
Mud to 400', 40 sx cement
Mud to 40', plug, 12 sx cement
3 sx in rat hole

RECEIVED
MAY 27 1979
05-29-79


(If additional description is necessary, use BACK of this sheet)

Name of Plugging Contractor

STATE OF KANSAS COUNTY OF SEDGWICK, ss.
Donald E. Hunt (employee of owner) or (owner or operator)
of the above-described well, being first duly sworn on oath, says: That I have knowledge of the facts, statements, and matters herein contained and the log of the above-described well as filed and that the same are true and correct. So help me God.

(Signature) Donald E. Hunt
Suite 250, 200 West Douglas, Wichita, Kansas
(Address)

My commission expires January 4, 1981
Described and sworn to before me this 26th day of May, 1979

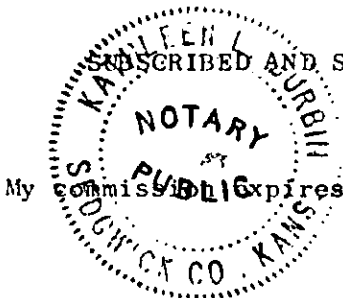

Kathleen L. Durbin Notary Public.

DRILLERS LOG

#8 BECK
 NE NW NW Section 12-27S-13W
 Pratt County, Kansas

OPERATOR: DUNNE EQUITIES, INC.
 Suite 140, 260 North Rock Road
 Wichita, Kansas 67206

CONTRACTOR: DUNNE-GARDNER PETROLEUM, INC.
 Suite 250, 200 West Douglas
 Wichita, Kansas 67202

COMMENCED: May 16, 1979

COMPLETED: May 22, 1979

CASING RECORD: 8-5/8" @ 412' w/350 sx

<u>FROM</u>	<u>TO</u>	<u>DESCRIPTION</u>
0	415	Sand and blue shale
415	1335	Red bed and sand
1335	1488	Shale
1488	1900	Anhydrite
1900	3730	Shale and lime
3730	4180	Lime
4180	4290	Lime and chert
4290		Rotary total depth

STATE OF KANSAS)
)
 COUNTY OF SEDGWICK) ss.

I hereby certify that the above is a true and correct log to the best of my knowledge and belief.

Donald E. Hunt
 Donald E. Hunt

Subscribed and sworn to before me this 24th day of May, 1979.

My appointment expires:
 January 4, 1981

Kathleen L. Durbin
 Notary Public

