

15-071-20302-00-00

STATE OF KANSAS
STATE CORPORATION COMMISSION


Form CP-4

Give All Information Completely
Make Required Affidavit
Mail or Deliver Report to:

Conservation Division
State Corporation Commission
P. O. Box 17027

Wichita, Kansas 67217
NORTH

WELL PLUGGING RECORD

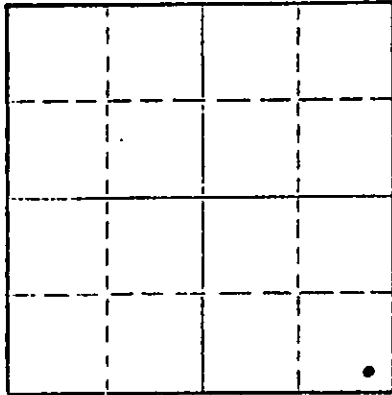

Locate well correctly on above
Section Plat

Greeley County, Sec. 30 Twp. 17S. Rge. 39 (X) X (W)
Location as "NE/CNWXSWX" or footage from lines C SE SE SE
Lease Owner Bartling Oil Company
Lease Name Wear Trust Well No. 2
Office Address 8550 Katy Freeway, Ste. 128, Houston, TX 77024
Character of Well (completed as Oil, Gas or Dry Hole) Gas - non commercial
Date well completed September 17 1983
Application for plugging filed November 28 1983
Application for plugging approved December 8 1983
Plugging commenced December 13 1983
Plugging completed December 13 1983
Reason for abandonment of well or producing formation non-commercial

If a producing well is abandoned, date of last production None 19__
Was permission obtained from the Conservation Division or its agents before plugging was commenced? Yes

Name of Conservation Agent who supervised plugging of this well Paul Luthi
Producing formation Chase Depth to top 2913 Bottom 3024 Total Depth of Well 3070 Feet
Show depth and thickness of all water, oil and gas formations.

OIL, GAS OR WATER RECORDS			CASING RECORD			
FORMATION	CONTENT	FROM	TO	SIZE	PUT IN	PULLED OUT
Upper Winfield	Water	2913	2925	8-5/8"	305'	None
Lower Winfield	Water	2925	2977	4-1/2"	3035'	None
Upper Ft Riley	Water	2977	3006			
Lower Ft Riley	Water	3006	3024			

Describe in detail the manner in which the well was plugged, indicating where the mud fluid was placed and the method or methods used in introducing it into the hole. If cement or other plugs were used, state the character of same and depth placed, from ___ feet to ___ feet for each plug set.

RU Howco - pumped down casing 25 sx 60/40 Pozmix mixed w/ 1 sx cottonseed hulls w/ 2% gel and 3% CaCl followed by 10 sx gel plus 125 sx 60/40 Pozmix w/ 2% gel and 3% CaCl. SI 500#. Supervised by Paul Luthi - Kansas Corporation Commission Field Plugging Representative.

RECEIVED
STATE CORPORATION COMMISSION

DEC 21 1983

CONSERVATION DIVISION
Wichita, Kansas

Name of Plugging Contractor Halliburton
Address Lamar, Colorado
(If additional description is necessary, use BACK of this sheet)

STATE OF Kansas COUNTY OF Seward ss.
R. L. Higginbottom (employee of owner) or (owner or operator) of the above-described well, being first duly sworn on oath, says: That I have knowledge of the facts, statements, and matters herein contained and the log of the above-described well as filed and that the same are true and correct. So help me God.

(Signature) *R. L. Higginbottom*
P.O. Box 6 Liberal, KS 67901
(Address)

SUBSCRIBED AND SWORN TO before me this 20th day of December, 1983

My commission expires
NOTARY PUBLIC - State of Kansas
A. J. PARNELL
My Appt. Exp. 7-7-85

A. J. Parnell
Notary Public.