


15-071-20105-00-08

STATE OF KANSAS
STATE CORPORATION COMMISSION

WELL PLUGGING RECORD

Give All Information Completely
Make Required Affidavit
Mail or Deliver Report to
Conservation Division
State Corporation Comm.
245 North Water
Wichita, KS 67202

Greeley County. Sec. 28 Twp. 17S Rge. 39W XXX
Location as "NE/CNW SW 1/4" or footage from lines
C-SE-SE
Lease Owner AMPECO
Lease Name Kleymann Well No. 1
Office Address Two N. Park East, Suite 800, Dallas Tex 75231
Character of Well (Completed as Oil, Gas or Dry Hole) _____
Gas
Date Well completed _____ 19____
Application for plugging filed Feb. 20 1980
Application for plugging approved Feb. 22 1980
Plugging commenced June 3 1980
Plugging completed June 6 1980
Reason for abandonment of well or producing formation _____
Non-Commercial Value
If a producing well is abandoned, date of last production _____ 19____

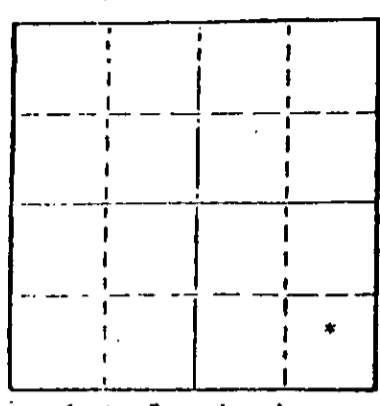

Name of Conservation Agent who supervised plugging of this well Mr Balthazor
Producing formation Hugoton Depth to top 2936 Bottom 2954 Total Depth of Well 3035
Show depth and thickness of all water, oil and gas formations.

OIL, GAS OR WATER RECORDS

CASING RECORD

FORMATION	CONTENT	FROM	TO	SIZE	PUT IN	PULLED OUT
Surface				8 5/8"	264	0'
Production				4 1/2"	3028	2051'

Describe in detail the manner in which the well was plugged, indicating where the mud fluid was placed and the method or methods used in introducing it into the hold. If cement or other plugs were used, state the character of same and depth placed, from _____ feet to _____ feet for each plug set.

Pumped 1 sk. bulls & 15 sks. cement to 2900' Pressured to 750 lbs.
Displaced to 950'
Pumped 50 sks. cement 950' to 800'
Displaced to 260'
Pumped 20 sks. cement 260' to 180'
Displaced to 40'
Put bridge & 10 sks. cement 40' to 0'
Cut off 8 5/8", 42" below ground level 06-19-80

(If additional description is necessary, use BACK of this sheet)

Name of Plugging Contractor Midwest Casing Pulling
Box F, Sublette, Ks. 67877 Permit #766

STATE OF Kansas COUNTY OF Haskell, ss.
I, Edgar J Eves (employee of owner) or (owner or operator)

of the above-described well, being first duly sworn on oath, says: That I have knowledge of the facts, statements, and matters herein contained and the log of the above-described well as filed and that the same are true and correct. So help me God.

(Signature) [Signature]
Box F, Sublette, Ks. 67877
(Address)

SUBSCRIBED AND SWORN TO before me this 16th day of June, 1980

Sondra L Eves
Notary Public.

My commission expires 12-6-80



[Handwritten initials]

KANSAS DRILLER'S LOG

15-071-20105-00-00

LEASE: KLEYMANN #1
 OWNER: AMERICAN PUBLIC ENERGY CO.
 CONT: EARL F. WAKEFIELD, INC.
 SPUD: 4-12-76
 COMP: 4-17-76

LOCATION: 660' FEL & 660' FSL
 Section 28-17S-39W
 GREELEY COUNTY, KANSAS
 CASING: 8 5/8" SET @ 263.62'
 4 1/2" SET @ 3020'

Shales	504
Blue shale & lime	1357
Blue shale & lime, anhydrite	1703
Lime & shale	1985
Anhydrite, lime & shale	2290
Shale & lime	2495
Lime, shale, & anhydrite	2700
Lime & shale	2865
Shale & lime	3035
R.T.D.	3035

STATE OF KANSAS)
)
 COUNTY OF SEDGWICK) ss

I, Gerald L. Mason, do hereby certify that this is a true and correct log on the KLEYMANN #1, located at 660' FEL & 660' FSL, Section 28-17S-39W, Greeley County, Kansas, as shown by the daily drilling reports.

EARL F. WAKEFIELD, INC.

By *Gerald L. Mason*
 Gerald L. Mason

Subscribed and Sworn to before me this 28th day of April, 1976.

My commission expires:
 October 22, 1976

Carol Jean Noel
 Carol Jean Noel - Notary Public

