


WELL PLUGGING RECORD

Give All Information Completely
Make Required Affidavit
Mail or Deliver Report to:
Conservation Division
State Corporation Commission
800 Bitting Building
Wichita, Kansas

NORTH

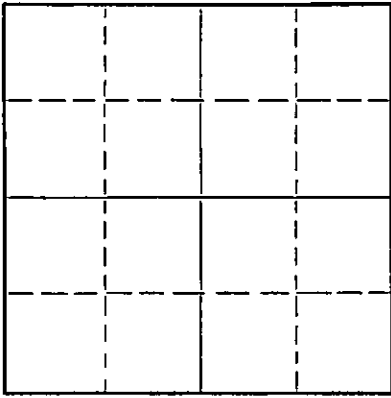

Locate well correctly on above
Section Flat

Scott

County, Sec. 29 Twp. 18 S Rge. 32 (W)

Location as "NE/CNW $\frac{1}{4}$ SW $\frac{1}{4}$ " or footage from lines NE NE NE

Lease Owner Herndon Drilling Company et al

Lease Name HARRIS Well No. 1

Office Address 423 Mayo Building, Tulsa, Oklahoma

Character of Well (completed as Oil, Gas or Dry Hole) Dry

Date well completed 4-17-52 19

Application for plugging filed 4-18-52 19

Application for plugging approved 4-18-52 19

Plugging commenced 4-18-52 - 2:00 P.M. 19

Plugging completed 4-18-52 - 4:00 P.M. 19

Reason for abandonment of well or producing formation Dry

If a producing well is abandoned, date of last production 19

Was permission obtained from the Conservation Division or its agents before plugging was commenced? Yes

Name of Conservation Agent who supervised plugging of this well Chas. Stough, Great Bend, Kansas

Producing formation Depth to top Bottom Total Depth of Well 4785 Feet

Show depth and thickness of all water, oil and gas formations.

OIL, GAS OR WATER RECORDS

CASING RECORD

Formation	Content	From	To	Size	Put In	Pulled Out
Sand	Surface pipe	0	290	8-5/8 J55	290'	None

Describe in detail the manner in which the well was plugged, indicating where the mud fluid was placed and the method or methods used in introducing it into the hole. If cement or other plugs were used, state the character of same and depth placed, from 270 feet to 35 feet for each plug set.

After drill pipe was laid down, heavy mud was stirred up in pits and pumped into hole to 270 feet. Bottom plug was set and 20 sacks of cement were mixed and poured through drill pipe. Hole was filled up to 35 feet of base of cellar and 10 sacks mixed and poured through drill pipe.

HERNDON
STATE CORPORATION COMMISSION
4-26-52

(If additional description is necessary, use BACK of this sheet)

Name of Plugging Contractor Herndon Drilling Company

Address 423 Mayo Building (Drawer 489), Tulsa, Oklahoma

STATE OF Oklahoma, COUNTY OF Tulsa, ss
JACK HERNDON (employee of owner) or (owner or operator) of the above-described well,
being first duly sworn on oath, says: That I have knowledge of the facts, statements, and matters herein contained and the log of the above-described well as filed and that the same are true and correct. So help me God.

(Signature) [Signature] Vice-President
Tulsa, Oklahoma (Address)

SUBSCRIBED AND SWORN to before me this 25th day of April, 1952

My commission expires Sept. 19, 1952

[Signature] Notary Public.

23-6390-3 0-31-20M
PLUGGING
FILE REC-297-18-324
BOOK PAGE 10 LINE 17

WELL LOG ON HARRIS #1

Spudding date: 3/21/52
 Date casing set: Plugged 4/18/52
 Date rotary completed: 4/17/52
 Date cable completed:

Location:
 Section 39-18S-32W, Scott
 County, Kansas

FROM	TO	FORMATION	REMARKS
0	105	Surface	Ran 10 jts of 8-5/8" csg.
105	925	Shale & shells	Set @ 290'. Cemented w/175
925	1645	Shale	sxs. of cement.
1645	1670	Shale & shells	
1670	2285	Shale	
2285	2440	Shale & shells	
2440	2575	Shale & lime	
2575	2655	Lime	
2655	2715	Anhydrite & shale	
2715	3160	Lime	
3160	3210	Lime & shale	
3210	3280	Lime	
3280	3320	Lime & shale	
3320	3385	Lime	
3385	3460	Shale & lime	
3460	3645	Lime	
3645	3670	Shale & lime	
3670	4088	Lime	
4088	4105	Lime & chert	
4105	4785	Lime	
4785		TOTAL DEPTH	

Plugging Record:

Filled hole w/heavy mud to 270' set bottom plug cemented w/20 sxs. of cement mixed and poured thru drill pipe finished filling hole w/mud to 35' of base of cellar set top plug and cemented w/10 sxs. of cement.

RECEIVED
 STATE CORPORATION COMMISSION

APR 26 1952

CONSERVATION DIVISION

Wichita, Kansas

Subscribed and sworn to before me this 22nd
 day of April, 19 52.

I certify the above and foregoing to be a true and exact
 copy of the original driller's log on the HARRIS #1

HERNDON DRILLING COMPANY

Ed. Berger
 Notary Public

My commission expires:

My commission expires Aug. 28, 1955

By: *R. E. Poyner*
 Title: *Secretary*

PLUGGING
 FILE SEC 29T 18 R 32W
 BOOK PAGE 42 LINE 7