


STATE OF KANSAS
STATE CORPORATION COMMISSION

Form CP-4

WELL PLUGGING RECORD

Give All Information Completely
Make Required Affidavit
Mail or Deliver Report to:
Conservation Division
State Corporation Commission
P. O. Box 17027
Wichita, Kansas 67217

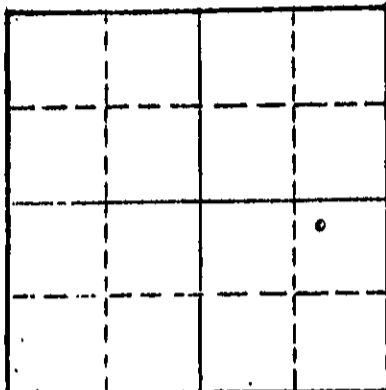

Locate well correctly on above
Section Plot

Scott County, Sec. 24 Twp. 18 Rge. 32 (E) W (W)
Location as "NE/CNW/SE" or footage from lines NW NE SE
Lease Owner DONALD C. SLAWSON
Lease Name Grube 'A' No. 1 Well No. 1
Office Address 408 One Twenty Building, Wichita, Kansas 67202
Character of Well (completed as Oil, Gas or Dry Hole) oil
Date well completed April 13, 1973 19
Application for plugging filed Yes (by Sargent's Casing Pulling) 19
Application for plugging approved Yes 19
Plugging commenced 6-7-74 19
Plugging completed 7-2-74 19
Reason for abandonment of well or producing formation
Uneconomical to produce
If a producing well is abandoned, date of last production October 1 1973
Was permission obtained from the Conservation Division or its agents before plugging was commenced? Yes

Name of Conservation Agent who supervised plugging of this well Leo Massey
Producing formation L-Kansas City Depth to top Bottom Total Depth of Well 4315 Feet
Show depth and thickness of all water, oil and gas formations.

OIL, GAS OR WATER RECORDS

CASING RECORD

FORMATION	CONTENT	FROM	TO	SIZE	PUT IN	PULLED OUT
		0	682	8-5/8"	682'	None
				4-1/2"	4314'	3026'

Describe in detail the manner in which the well was plugged, indicating where the mud fluid was placed and the method or methods used in introducing it into the hole. If cement or other plugs were used, state the character of same and depth placed, from feet to feet for each plug set.

6/7/74 Pumped 15 sax cement & 1 1/2 sax hulls to 3800' @ 1200 psi pressure

Pulled 4 1/2" casing

7/2/74 Rig up Halliburton.


4314' to 2587 Mud
2587 to 1087 30 sax gel & 3 sacks Hulls
846 to 1087 70 sax cement
103 to 846' 15 sax Gel
0 to 103' 30 sax cement

(If additional description is necessary, use BACK of this sheet)

Name of Plugging Contractor Halliburton Services
Address 410 Union Center Building, Wichita, Kansas 67202

STATE OF Kansas COUNTY OF Sedgwick
James C. Remsberg (employee of owner) or (owner or operator) of the above-described well, being duly sworn on oath, says: That I have knowledge of the facts, statements, and matters herein contained and the log of the above-described well as filed and that the same are true and correct. So help me God.

(Signature) James C. Remsberg
408 One Twenty Building (Address)

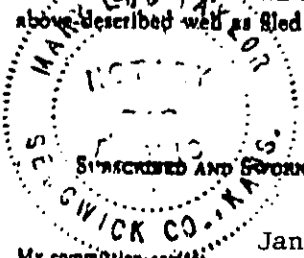

Witnessed and sworn to before me this 19 day of July 1974
Mary Taylor Notary Public

WELL LOG

COMPANY: Donald C. Slawson
 408 One Twenty Building
 Wichita, Kansas 67202

LEASE NAME: Grube 'A' #1
 NW NE SE Sec. 24-18S-32W
 Scott County, Kansas

TOTAL DEPTH: 4315 feet

COMMENCED: February 28, 1973

COMPLETED: April 13, 1973

CONTRACTOR: Cimarron Drillers Inc. to 2340 feet
 Slawson Drilling Company, Inc. 2340 feet to rotary total depth

CASING: 8 5/8" 2 682' w/225 sx

RECEIVED
 STATE CORPORATION COMMISSION
 APR 3 - 1974
 CONSERVATION DIVISION
 Wichita, Kansas

0-2341	Washing in hole
2341-3102	Lime & Shale
3102-4315	Lime
4315	RTD

STATE OF KANSAS)
) SS.
 COUNTY OF SEDGWICK)

I, JAMES C. REMSBERG, of the Slawson Drilling Company, Inc., upon oath state that the above and foregoing is a true and correct copy of the log of the Grube 'A' #1 well.

James C. Remsberg
 JAMES C. REMSBERG

Subscribed and sworn to before me this 26th day of April, 1973.

Dolores B. Coady
 Dolores B. Coady, Notary Public

My Commission Expires:

DOLORES B. COADY
 STATE NOTARY PUBLIC
 SEDGWICK COUNTY, KANSAS
 Comm. Expires Mar. 7, 1976