


15-171-20157-0000

STATE OF KANSAS
STATE CORPORATION COMMISSION

WELL PLUGGING RECORD

Give All Information Completely
Make Required Affidavit
Mail or Deliver Report to
Conservation Division
State Corporation Comm.
245 North Water
Wichita, KS 67202

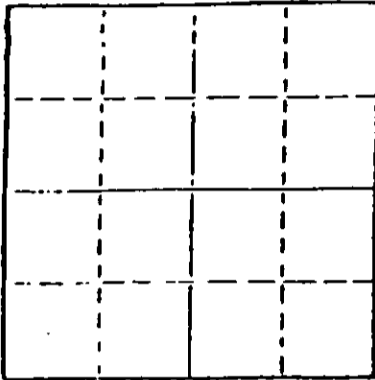

Locate well correctly on above
Section Plat

Scott County, Sec. 24 Twp. 18S Rge. 32 E/W
Location as "NE/CNW/SW" or footage from lines
SE SW NE

Lease Owner Kimbark Operating Co.
Lease Name Janssen Well No. _____
Office Address 808 Lincoln Tower, 1860 Lincoln, Denver, Co.
Character of Well (Completed as Oil, Gas or Dry Hole) 80203

Dry Hole
Date Well completed 4-1-78 19
Application for plugging filed 4-1-78 19
Application for plugging approved 4-1-78 19
Plugging commenced 4-1-78 19
Plugging completed 4-1-78 19

Reason for abandonment of well or producing formation
commercial quantities of oil not found
If a producing well is abandoned, date of last production 19

Was permission obtained from the Conservation Division or
its agents before plugging was commenced? Yes

Name of Conservation Agent who supervised plugging of this well Gilbert Balthazor, Palco, Ks.
Producing formation _____ Depth to top _____ Bottom _____ Total Depth of Well 4610'
Show depth and thickness of all water, oil and gas formations.

OIL, GAS OR WATER RECORDS

CASING RECORD

FORMATION	CONTENT	FROM	TO	SIZE	PUT IN	PULLED OUT
				8-5/8"	333'	

Describe in detail the manner in which the well was plugged, indicating where the mud fluid
was placed and the method or methods used in introducing it into the hold. If cement or other
plugs were used, state the character of same and depth placed, from _____ feet to
_____ feet for each plug set.

Plugged @ 1050' with 70 sx.
300' with 20 sx.
40' with 10 sx.
Rat Hole with 2 sx.

RECEIVED
STATE CORPORATION COMMISSION
APR 21 1978

CONSERVATION DIVISION
Wichita, Kansas

(If additional description is necessary, use BACK of this sheet)

Name of Plugging Contractor Rains & Williamson Oil Co., Inc.

STATE OF KANSAS COUNTY OF SEDGWICK, ss.
Wilson Rains, President of Rains & Williamson Oil Co., Inc. (employee of owner) or (owner or operator)
of the above-described well, being first duly sworn on oath, says: That I have knowledge of
the facts, statements, and matters herein contained and the log of the above-described well
as filed and that the same are true and correct. So help me God.

(Signature) Wilson Rains Wilson Rains
435 Page Ct., 220 W. Douglas, Wichita, Ks. 67202
(Address)

Subscribed and sworn to before me this 5th day of April, 1978

Juanita M. Green
Juanita M. Green Notary Public.

My commission expires October 4, 1979



DRILLER'S LOG

15-171-20157-0000

COMPANY: Kimbark Operating Co.

SEC. 24 T. 18S R. 32W

WELL NAME: Janssen #1

LOC. SE SW NE

COUNTY: Scott

RIG NO. 1

TOTAL DEPTH 4610'

ELEVATION

COMMENCED: 3-20-78

COMPLETED: 4-1-78

CONTRACTOR: Rains & Williamson Oil Co., Inc.

CASING RECORD:

SURFACE: 8-5/8" set @ 333' w/250 sx. 50/50 poz., 3% cc., 2% gel.

PRODUCTION: D & A

LOG

(Figures Indicate Bottom of Formations)

Surface	334
Shale and Sand	1680
Sand and Shale	2180
Shale and Sand	2276
Anhydrite	2292
Shale and Sand	2654
Shale	3006
Shale and Lime	3196
Shale	3543
Shale and Lime	3836
Lime and Shale	3992
Lime	4079
Lime and Shale	4610
<u>Rotary Total Depth</u>	<u>4610</u>

RECEIVED
STATE CORPORATION COMMISSION

APR 21 1978

CONSERVATION DIVISION
Wichita, Kansas

STATE OF KANSAS)
COUNTY OF SEDGWICK)

SS:

I, Wilson Rains, President of Rains & Williamson Oil Co., Inc.
upon oath state that the above and foregoing is a true and correct copy of the log of the
Janssen #1 well.

Wilson Rains
Wilson Rains

Subscribed and sworn to before me this 5th day of April, 1978.

My Appointment Expires:
October 4, 1979

Juanita M. Green
Juanita M. Green - Notary Public

