


Give All Information Completely
Make Required Affidavit
Mail or Deliver Report to:
Conservation Division
State Corporation Commission
800 Biting Building
Wichita, Kansas

WELL PLUGGING RECORD

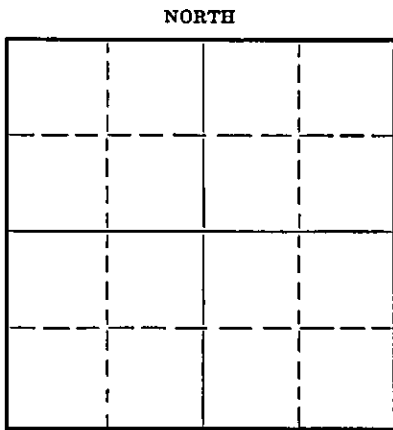

Locate well correctly on above
Section Plat

Saline County, Sec. ² 14 Twp. 15 Rge. 4 (E) (W)
Location as "NE/CNW¹/₄SW¹/₄" or footage from lines 1450' from W. line, 150' from
Lease Owner J.A. Davis - J.H. Child N. line SE¹/₄
Lease Name Dahlsten et al Well No. 4
Office Address 121 West Second, Hutchinson, Ks.
Character of Well (completed as Oil, Gas or Dry Hole) Dry Hole
Date well completed 10-13 19 51
Application for plugging filed 10-13 19 51
Application for plugging approved 10-13 19 51
Plugging commenced 10-13 19 51
Plugging completed 10-13 19 51
Reason for abandonment of well or producing formation Dry Hole

If a producing well is abandoned, date of last production 19
Was permission obtained from the Conservation Division or its agents before plugging was com-
menced? Yes

Name of Conservation Agent who supervised plugging of this well Ruel E. Durkee
Producing formation Depth to top Bottom Total Depth of Well 3431' Feet
Show depth and thickness of all water, oil and gas formations.

OIL, GAS OR WATER RECORDS

CASING RECORD

Formation	Content	From	To	Size	Put In	Pulled Out
				13"	109'	
				8-5/8"	353'	

Describe in detail the manner in which the well was plugged, indicating where the mud fluid was placed and the method or methods used in introducing it into the hole. If cement or other plugs were used, state the character of same and depth placed, from feet to feet for each plug set.

Loaded hole with heavy mud.
Set plug at 160'. Cemented with 15 sacks
through drill pipe. Set top plug at 25'.
Cemented with 5 sacks.

(If additional description is necessary, use BACK of this sheet)

Correspondence regarding this well should be addressed to Sterling Drilling Company
Address Sterling, Kansas

STATE OF Kansas, COUNTY OF Rice, ss.
Rollin Mead (employee of owner) of the above-described well,
being first duly sworn on oath, says: That I have knowledge of the facts, statements, and matters herein contained and the log of the above-described well as filed and that the same are true and correct. So help me God.

(Signature) *Rollin Mead*
Sterling, Kansas (Address)

SUBSCRIBED AND SWORN TO before me this 15th day of October, 19 51

My commission expires 9-17-53

PLUGGING
FILE SEC 34 OCT 15 1951
BOOK PAGE 116 LINE 25

Notary Public

STERLING DRILLING CO.

STERLING, KANSAS

WELL LOG ----- DAHLSTEN #4

Location - 1450' from West Line, 150' from North Line
SE/4 of Section 34-15-4, Saline County, Kansas.

Owner - J. A. Davis - J. H. Child et al
Contractor - Sterling Drilling Company

Commenced - 9-29-51
Completed - 10-13-51

Total Depth - 3431'

ELEVATION: 1304' LF
1301' Gr

LOG

0- 190	Clay and Sand
190- 273	Shale
273- 735	Lime
735- 750	Clay
750-1200	Lime and Shale
1200-1840	Shale
1840-2300	Shale and Lime
2300-2585	Lime
2585-2730	Lime and Shale
2730-2880	Shale
2880-3180	Lime
3180-3223	Lime and Shale
3223-3285	Shale
3285-3360	Shale and Lime
3360-3428	Shale
3428-3431	Maquoketa Lime

CASING RECORD

109' of 13" Surface Pipe
Cemented with 100 Sacks thro pipe and
86 around outside pipe
(3 Sacks Calcium Chloride)

353' of 8-5/8" Surface Pipe set at 345'
Cemented bottom with 125 Sacks; top 1"
pipe with 10 Sacks Cal Seal & 41 Sacks
Cement

PRODUCTION: Dry and Abandoned

STERLING DRILLING CO.
OCT 16 1951
GENERAL INVESTIGATION
Wichita, Kansas

DRILLING
34-15-4
116-45