


WELL PLUGGING RECORD

Give All Information Completely
Make Required Affidavit
Mail or Deliver Report to:
Conservation Division
State Corporation Commission
800 Bitting Building
Wichita, Kansas

NORTH

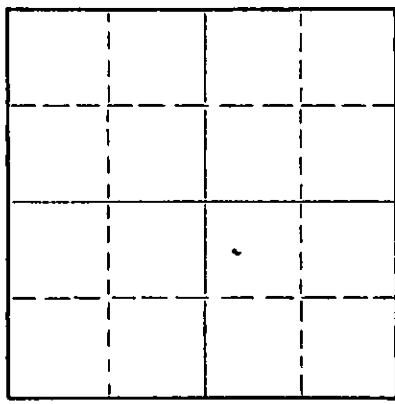

Locate well correctly on above
Section Plat

Salina County. Sec. 24 Twp. 15 Rge. 4 (E) (W)
Location as "NE/CNW/SW" or footage from lines SE-SW-SE
Lease Owner J. A. Davis - J. H. Child
Lease Name Dahlsteen Well No. 3
Office Address Hutchinson, Kansas
Character of Well (completed as Oil, Gas or Dry Hole) Oil
Date well completed June 1, 1951
Application for plugging filed June 17, 1955-verbal
Application for plugging approved June 17, 1955
Plugging commenced June 30
Plugging completed July 6
Reason for abandonment of well or producing formation

If a producing well is abandoned, date of last production 19
Was permission obtained from the Conservation Division or its agents before plugging was commenced? Yes

Name of Conservation Agent who supervised plugging of this well Rel Durkee
Producing formation _____ Depth to top _____ Bottom _____ Total Depth of Well 3420 Feet
Show depth and thickness of all water, oil and gas formations.

OIL, GAS OR WATER RECORDS

CASING RECORD

FORMATION	CONTENT	FROM	TO	SIZE	PUT IN	PULLED OUT
				8-5/8"	320'	None
				5-1/2"	3418'	2836'

Describe in detail the manner in which the well was plugged, indicating where the mud fluid was placed and the method or methods used in introducing it into the hole. If cement or other plugs were used, state the character of same and depth placed, from _____ feet to _____ feet for each plug set.

Filled hole with sand to 3400'. Dumped 6 sacks of cement. Shot pipe off at 2836'. Pulled pipe and mudded hole to 180'. Set rock bridge and dumped 15 sacks of cement at 180'. Finished mudding hole and dumped 5 sacks of cement at base of cellar.

7-16-55

(If additional description is necessary, use BACK of this sheet)

Name of Plugging Contractor Bert Self
Address Hutchinson, Kansas

STATE OF Kansas COUNTY OF Reno ss.
Employee (employee of owner) or (owner or operator) of the above-described well, being first duly sworn on oath, says: That I have knowledge of the facts, statements, and matters herein contained and the log of the above-described well as filed and that the same are true and correct. So help me God.

(Signature) Bert Self
R. R. #4, Hutchinson, Kans.
(Address)

SUBSCRIBED AND SWORN TO before me this 9th day of July, 19 55

My commission expires August 12, 1957
Notary Public.

PLUGGING
FILE SEC-24 T-15 R-4W
BOOK PAGE 127 LINE 42

15-169-008420000

STERLING DRILLING CO.

STERLING, KANSAS

WELL LOG - - - - - DAHLSTEN #3

Location - SE/4 SW/4 SE/4 of Section 24-15-4, Saline County, Kansas

Owner - Messrs. J. A. Davis and J. H. Child
Rotary Drilling Contractor - Sterling Drilling Company
Cable Tools Contractor - Sterling Drilling Company

Commenced - 4-27-51
Completed - 5-9-51 (w/r)
 - 6-1-51 (w/c.t.)

Total Depth - 3411' (w/r)
 - 3411' 8" (w/c/t)

ELEVATION - 1293 DF
 1281 Gr

LOG

0- 125	Surface Clay and Shale
125- 315	Shale
315- 345	Anhydrite
345- 475	Lime
475- 620	Lime and Shale
620-1030	Lime
1030-1600	Shale and Shells
1600-2150	Lime and Shale
2150-2250	Shale
2250-2550	Lime
2550-2640	Lime and Shale
2640-2790	Lime
2790-2863	Lime and Shale
2863-2880	Lime - Mississippi
2880-3040	Lime
3040-3125	Lime and Chert
3125-3150	Lime
3150-3200	Lime and Shale
3200-3275	Shale
3275-3325	Shale and Lime
3325-3408	Shale
3408-3411	Lime

3411-3411' 8" - Lime

CASING RECORD

320' of 8-5/8" Surface Pipe
Cemented with 225 Sacks Cement

3418' of 5 1/2" O. D. Casing
Cemented with 50 Sacks Cement
(3' off bottom)

PLUGGING
 FILE SEC-24T-15-R-4W
 BOOK PAGE 122 LINE 40

CABLE TOOLS RECORD: Drilled plug. Cleaned out to bottom. Swab test showed well making 1 bbl. oil per hr. Drilled 8 in. of new hole. Shot with 16 shots between 3407'-3410 1/2'. Cleaned out to bottom. Swab test showed well making 3 bbls. oil per hr. Well put on pump.