


Give All Information Completely  
Make Required Affidavit  
Mail or Deliver Report to:  
Conservation Division  
State Corporation Commission  
800 Biting Building  
Wichita, Kansas

WELL PLUGGING RECORD

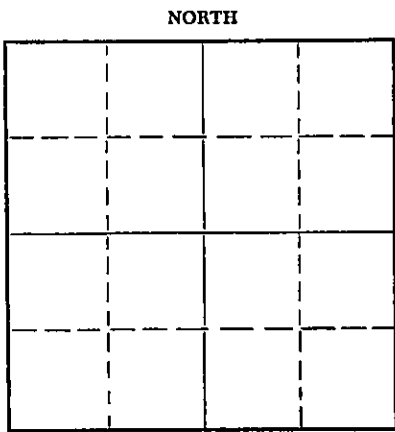

Locate well correctly on above Section Flat

Saline County, Sec. 4 Twp. 15 Rge. 4 (X) (W)  
Location as "NE/CNW/SE/SW" or footage from lines SE SE SW  
Lease Owner Louis Kitsis, et al  
Lease Name Phelps Well No. 1  
Office Address c/o Shields Drilling Co., Inc. - Box 248 - Russell, Kansas  
Character of Well (completed as Oil, Gas or Dry Hole) Dry Hole  
Date well completed August 20, 1953  
Application for plugging filed August 20, 1953  
Application for plugging approved August 20, 1953  
Plugging commenced August 20, 1953  
Plugging completed August 21, 1953  
Reason for abandonment of well or producing formation Dry Hole

If a producing well is abandoned, date of last production 19  
Was permission obtained from the Conservation Division or its agents before plugging was commenced? yes

Name of Conservation Agent who supervised plugging of this well Ruel Durkee  
Producing formation \_\_\_\_\_ Depth to top \_\_\_\_\_ Bottom \_\_\_\_\_ Total Depth of Well \_\_\_\_\_ Feet  
Show depth and thickness of all water, oil and gas formations.

OIL, GAS OR WATER RECORDS

CASING RECORD

FORMATION	CONTENT	FROM	TO	SIZE	PUT IN	PULLED OUT
Viola	Water	3660	3670	8 5/8"	421'	Cmtd. w/ 250 sax

Describe in detail the manner in which the well was plugged, indicating where the mud fluid was placed and the method or methods used in introducing it into the hole. If cement or other plugs were used, state the character of same and depth placed, from \_\_\_\_\_ feet to \_\_\_\_\_ feet for each plug set.

Heavy mud from bottom to 190'  
Bridge set @ 190' with 15 sacks cement  
Heavy mud to 20'  
Five sacks cement to surface

(If additional description is necessary, use BACK of this sheet)

Name of Plugging Contractor Shields Drilling Company, Inc.  
Address Box 248 - Russell, Kansas


STATE OF KANSAS COUNTY OF RUSSELL, ss.  
R. J. Shields (Employee of Owner) or (owner or operator) of the above-described well, being first duly sworn on oath, says: That I have knowledge of the facts, statements, and matters herein contained and the log of the above-described well as filed and that the same are true and correct. So help me God.

(Signature) [Signature] -President  
Box 248 - Russell, Kansas  
(Address)

SUBSCRIBED AND SWORN TO before me this 21st day of August, 1953

My commission expires May 28 - 1955 [Signature] Notary Public.

8-22-53

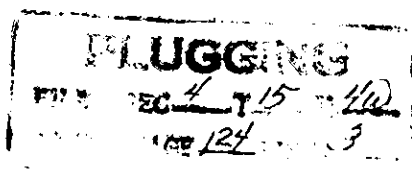

WELL LOG

15-169-00123-0000

LOUIS KITSIS et al  
Phelps #1

SE SE SW  
Sec. 4, Twp. 15S, Rge. 4W  
Saline County, Kansas

Total Depth: 3670  
Commenced: August 5, 1953  
Completed: August 20, 1953  
Drilled by Shields Drilling Co., Inc.

CASING RECORD

Size Run Pelled  
6 5/8" 4234 Cmtd. w/ 250 sax

Elevation: 1332' DF  
Treatment:  
Production: D & A

-----Figures Indicate Bottom of Formations-----

Shale & Shells	338
Shale & Gyp	410
Anhydrite	421
Broken Lime	462
Shale & Shells	820
Lime & Shale	975
Lime	1095
Lime & Shale	1110
Shale & Shells	1250
Shale & Salt	1285
Shale, Shells, & Salt	1515
Lime & Shale	1650
Shale & Lime	1945
Shale & Lime	2035
Broken Lime	2095
Lime & Shale	2425
Broken Lime	2945
Lime & Shale	2936
Shale & Broken Lime	2783
Shale & Lime	2839
Shale & Lime	2890
Shale	3079
Broken Lime	3108
Shale & Lime	3145
Lime & Shale	3425
Shale	3501
Lime	3530
Lime & Shale	3578
Shale	3620
Shale & Lime	3650
Victis Lime	3670 TD

TOPS

Victis Lime 3650

NOTE

Plugged hole with 20 sax cement

**PLUGGING**  
BOOK PAGE 124 LINE 3

RECEIVED  
STATE COMMISSION  
AUG 20 1953  
CONSERVATION DIVISION  
WICHITA, KANSAS