


WELL PLUGGING RECORD

Give All Information Completely
Make Required Affidavit
Fill or Deliver Report to:
Conservation Division
State Corporation Commission
800 Bitting Building
Wichita, Kansas

NORTH

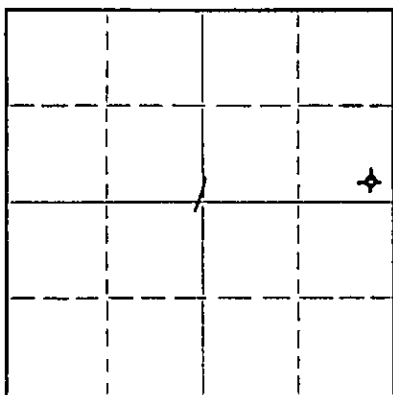

Locate well correctly on above
Section Plat

Saline County. Sec. 1 Twp. 15S Rge. 4 (E) (W)
Location as "NE/CNW $\frac{1}{4}$ /SW $\frac{1}{4}$ " or footage from lines SE/4 SE/4 NE/4
Lease Owner T. A. Phillips and J. L. Sanderson
Lease Name Leander Well No. 1
Office Address 535 State Street, Salina, Kansas
Character of Well (completed as Oil, Gas or Dry Hole) Dry
Date well completed October 24, 1951
Application for plugging filed October 24, 1951
Application for plugging approved October 24, 1951
Plugging commenced October 24, 1951
Plugging completed October 24, 1951
Reason for abandonment of well or producing formation Dry

If a producing well is abandoned, date of last production 19...
Was permission obtained from the Conservation Division or its agents before plugging was commenced? Yes

Name of Conservation Agent who supervised plugging of this well Ruel Durkee
Producing formation None Depth to top Bottom Total Depth of Well 366.9 Feet
Show depth and thickness of all water, oil and gas formations.

OIL, GAS OR WATER RECORDS

CASING RECORD

| Formation | Content | From | To | Size | Put In | Pulled Out |
|--------------------|---------|------|----|--------|--------|------------|
| Maquoketa Dolomite | Dry | 3642 | | 8-5/8" | 380 | None |
| | | | | | | |
| | | | | | | |
| | | | | | | |
| | | | | | | |

Describe in detail the manner in which the well was plugged, indicating where the mud fluid was placed and the method or methods used in introducing it into the hole. If cement or other plugs were used, state the character of same and depth placed, from... feet to... feet for each plug set.

Set Wood Plug at 165'
Cemented w/ 15 sacks
Mud from 165' to 25'
Set Wood Plug at 25'
Cemented w/ 5 sacks
Mud from 25' to 6'
Surface soil from 6' to top

(If additional description is necessary, use BACK of this sheet)
Name of Plugging Contractor J. A. Melland
Address 1111 North Main Street, Hutchinson, Kansas

STATE OF Kansas, COUNTY OF Saline, ss.

... (owner of the above-described well,
being first duly sworn on oath, says: That I have knowledge of the facts, statements, and matters herein contained and the log of the above-described well as filed and that the same are true and correct. So help me God.

(Signature) T. A. Phillips
535 State St. Salina, Kas.
(Address)

SUBSCRIBED AND SWORN to before me this 3rd day of November, 1951

My commission expires April 12, 1952 Notary Public.

PLUGGING
FILE SEC LT 15N
BOOK PAGE 149 LINE 25
NOV - 5 1951
CONSERVATION DIVISION
Wichita, Kansas

W E L L R E C O R D

15-169-00837-0009

LEASE NAME Leander WELL NO. 1 OWNER Phillips & Sanderson
 LOCATION SE/4 SE/4 NE/4 Section 1-188-4N, Saline County, Kansas
 WORK COMMENCED October 8, 1951 DRILLING COMMENCED October 10, 1951
 DRILLING COMPLETED October 24, 1951
 DRILLING CONTRACTOR J. A. Melland, Hutchinson, Kansas
 NOTARY DRILLING FROM 0' TO 3669'

| FORMATION | FROM | TO | REMARKS |
|------------------------|------|------|---|
| Shale and shells | 0 | 170 | |
| Shale, shells and salt | 170 | 370 | |
| Anhydrite | 370 | 388 | Set and cemented 8-6/8" OD casing at 380' with 200 sacks of cement. |
| Lime and shale | 388 | 498 | |
| Lime | 498 | 590 | |
| Shale and lime | 590 | 790 | |
| Lime and shale | 790 | 915 | |
| Lime | 915 | 980 | |
| Shale and lime | 980 | 2000 | |
| Shale and shells | 2000 | 2030 | |
| Lime | 2030 | 2095 | |
| Lime and shale | 2095 | 2575 | |
| Lime | 2575 | 2685 | |
| Shale and lime | 2685 | 2960 | |
| Lime and shale | 2960 | 3110 | Top Mississippi Lime 3087' |
| Lime | 3110 | 3305 | |
| Lime and chert | 3305 | 3330 | |
| Lime | 3330 | 3365 | |
| Lime and shale | 3365 | 3500 | Top Kinderhook Shale 3372' Top Niceney Sand 3487' Top Butler Dolomite 3491' |
| Lime | 3500 | 3555 | |
| Lime and shale | 3555 | 3615 | Top Maquoketa Shale 3567' |
| Shale | 3615 | 3642 | Top Maquoketa Dolomite 3642' |
| Lime | 3642 | 3669 | |
| TOTAL DEPTH | | 3669 | |

As all formations encountered were dry, authority was granted to plug and abandon the well under the supervision of Mr. Noel Durkee, S.C.C. well plugger, as follows: Set plug at 165' and cemented with 15 sacks of cement, mud from 165' to 25', set plug at 25' and cemented with 8 sacks of cement, mud from 25' to 6', surface soil from 6' to surface, finished plugging October 24, 1951. Slope tests taken at regular intervals showed no deflections from vertical.

PLUGGING
 FILE SEC 1 T 15 R 42
 BOOK PAGE 11 LINE 35

REC'D
 STATE COMMISSION
 NOV - 5 1951
 CONSERVATION DIVISION
 Wichita, Kansas