


WELL PLUGGING RECORD

Give All Information Completely  
Make Required Affidavit  
Mail or Deliver Report to:  
Conservation Division  
State Corporation Commission  
800 Bitting Building  
Wichita, Kansas

NORTH

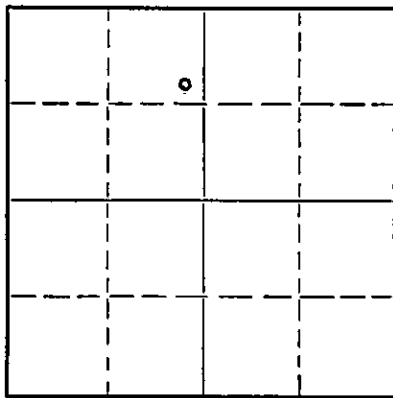

Locate well correctly on above  
Section Plat

SALINE County. Sec. 25. Twp. 15S Rge. 4 (E) W (W)  
Location as "NE/CNW1/4SW1/4" or footage from lines (760' ENL) SE NE NW  
Lease Owner CASEBEER SUPPLY  
Lease Name C. DAHLSTEN Well No. 2  
Office Address C/O DAVID LITAN BOX 91, MCPHERSON, KANSAS  
Character of Well (completed as Oil, Gas or Dry Hole) OIL  
Date well completed AUG. 24, 1951 19  
Application for plugging filed MARCH 15 19 54  
Application for plugging approved MARCH 18 19 54  
Plugging commenced MARCH 18 19 54  
Plugging completed MARCH 22 19 54  
Reason for abandonment of well or producing formation DEPLETED  
If a producing well is abandoned, date of last production FEB. 28, 19 54  
Was permission obtained from the Conservation Division or its agents before plugging was commenced? YES

Name of Conservation Agent who supervised plugging of this well MR. RUEL DURKEE  
Producing formation MAQUOKETA DOL. Depth to top 3417 Bottom 3424 Total Depth of Well 3424 Feet  
Show depth and thickness of all water, oil and gas formations.

OIL, GAS OR WATER RECORDS

CASING RECORD

Formation	Content	From	To	Size	Put In	Pulled Out
TOP SOIL & SAND		0	52'	13-3/8	52'	NONE
SHALE, SAND, SHELLS,	ANHYDRITE	0	320.00	8-5/8	323.99'	NONE
MAQUOK DOL. TOP		0	3417	5-1/2"	3419.5'	457'

Describe in detail the manner in which the well was plugged, indicating where the mud fluid was placed and the method or methods used in introducing it into the hole. If cement or other plugs were used, state the character of same and depth placed, from \_\_\_\_\_ feet to \_\_\_\_\_ feet for each plug set.

3424 TO 3410' SAND BRIDGE  
3410 TO 3380' 6 SX CEMENT  
3380 TO 180' MUDDED  
180 TO 170' ROCK BRIDGE  
170 TO 125' 15 SX CEMENT  
125 TO 15' MUD  
15' TO CELLAR 5 SX CEMENT

(If additional description is necessary, use BACK of this sheet)

Correspondence regarding this well should be addressed to DAVID LITAN  
Address BOX 91 MCPHERSON, KANSAS

STATE OF KANSAS, COUNTY OF MCPHERSON, ss.

(employee of owner) or (owner or operator) of the above-described well, being first duly sworn on oath, says: That I have knowledge of the facts, statements, and matters herein contained and the log of the above-described well as filed and that the same are true and correct. So help me God.

(Signature) David Litau  
DAVID LITAN  
BOX 91 MCPHERSON, KANSAS (Address)

SUBSCRIBED AND SWORN TO before me this 10<sup>th</sup> day of April, 1954

Signature of Notary Public

My commission expires Feb 4, 1956

PLUGGING  
FILED SEC 25 T 15 R 4W  
BOOK PAGE 20 LINE 18

4-12-54

