


STATE OF KANSAS
STATE CORPORATION COMMISSION

WELL PLUGGING RECORD

Give All Information Completely
Make Required Affidavit
Mail or Deliver Report to:
Conservation Division
State Corporation Commission
800 Bitting Building
Wichita, Kansas

NORTH

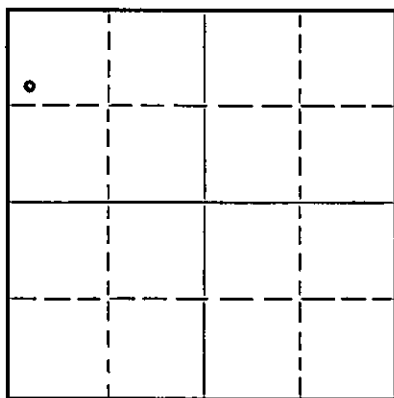

Locate well correctly on above
Section Plat

SALINE County. Sec. 25 Twp. 15 Rge. 4 (E) W (W)
Location as "NE/CNW $\frac{1}{4}$ SW $\frac{1}{4}$ " or footage from lines SW N/2 NW
Lease Owner CASEBEER SUPPLY
Lease Name C. DAHLSTEN #3 Well No. 3
Office Address C/O DAVID LITAN BOX 91 MCPHERSON, KANSAS
Character of Well (completed as Oil, Gas or Dry Hole) OIL
Date well completed JAN. 11 19 52
Application for plugging filed MARCH 16, 19 54
Application for plugging approved MARCH 18, 19 54
Plugging commenced MARCH 25 19 54
Plugging completed MARCH 28 19 54
Reason for abandonment of well or producing formation DEPLETED

If a producing well is abandoned, date of last production FEB. 28, 19 54
Was permission obtained from the Conservation Division or its agents before plugging was commenced? YES

Name of Conservation Agent who supervised plugging of this well MR. RUEL DURKEE
Producing formation MAQUOKETA DOL. Depth to top 3435 Bottom 3437 Total Depth of Well 3437 Feet
Show depth and thickness of all water, oil and gas formations.

OIL, GAS OR WATER RECORDS

CASING RECORD

Formation	Content	From	To	Size	Put In	Pulled Out
CLAY, SHALE, ANHYDRITE		0	320	8-5/8	330	NONE
TO MAQUOKETA TOP		0	3435	5-1/2	3435	2741'

Describe in detail the manner in which the well was plugged, indicating where the mud fluid was placed and the method or methods used in introducing it into the hole. If cement or other plugs were used, state the character of same and depth placed, from _____ feet to _____ feet for each plug set.

3200 TO 3180' SAND BRIDGE
3180' TO 3165' 6 SX CEMENT
3165' TO 180' MUDDED
180' TO 170' ROCK BRIDGE
170' TO 125' 15SX CEMENT
125' TO 30' MUD
30' TO CELLAR 10 SX CEMENT
COULD NOT GET TOOLS BELOW 3200' IN THIS HOLE

(If additional description is necessary, use BACK of this sheet)

Correspondence regarding this well should be addressed to DAVID LITAN
Address BOX 91 MCPHERSON, KANSAS

STATE OF MCPHERSON, COUNTY OF KANSAS, ss.

(employee of owner) or (owner or operator) of the above-described well, being first duly sworn on oath, says: That I have knowledge of the facts, statements, and matters herein contained and the log of the above-described well as filed and that the same are true and correct. So help me God.

(Signature) David Litau
DAVID LITAN
BOX 91 MCPHERSON, KANSAS
(Address)

SUBSCRIBED AND SWORN to before me this 10th day of April, 1954

Virginia L. Mader
Notary Public.

My commission expires 8-24-1956

PLUGGING
FILE SEC 25 T 15 R 4W
BOOK PAGE 20 LINE 19

4-12-54



Dealers in Scrap Iron • Used Pipe and
Oil Field Equipment

15:169:00733:0000

JOHN W. CASEBEER
MILFORD C. DECKER
MARTHA KENDALL

Office and Yard, 520 West Euclid
McPHERSON \ KANSAS

MAY 11, 1954

STATE CORPORATION COMMISSION
800 BITTING BLDG.
WICHITA, KANSAS

ATTENTION OF MR. S.S.GREIDER

DEAR SIR:

WITH REGARD TO YOUR REQUEST FOR A WELL LOG ON THE
C. DAHLSTEN #3, SW N/2 NW 25-15-4W SALINE COUNTY,
WE HAVE AGAIN MADE DUE EFFORT THROUGH OUR GEOLOGIST,
MR. DON MELLAND, TO OBTAIN A LOG ON THIS WELL. HE
REPORTS THAT THERE WAS NO WELL LOG TURNED IN ORIGINALLY
TO THE WELL LOG BUREAU OR ANY OTHER PLACE THAT HE HAD
ACCESS. MR. W.G. BRUNS, WHO ORIGINALLY DEVELOPED THE
LEASE HAS SINCE DIED AND HIS SON HAS NO LOG IN HIS FILES.

THE ONLY INFORMATION WE HAVE ON THIS WELL IS THE DATA
REPORTED ON THE INDEPENDENT COMPLETION CARDS, WHICH WE
HAVE SENT YOU WITH THE WELL PLUGGING RECORD. THE INFORM-
ATION WAS AS FOLLOWS:

DAHLSTEN #3	ELEV. 1310	SW NW NW
COMPLETED	1-11-32	SEC. 25-15-4W
MISSISSIPPI	2906 (-1596)	SALINE COUNTY, KAN.
MAQUOKETA	3435 (-2125)	

5 1/2" SET AT 3435'
T.D. 3437'

THE NEAREST WELL WAS THE DAHLSTEN #1 COMPLETED AS A DRY
HOLE, ON THE SAME LEASE. WE ARE ENCLOSING LOGS AND HOPE
THAT IT WILL BE OF ASSISTANCE SINCE THE MISSISSIPPI WAS
WITHIN 4' IN MINUS AND THE MAQUOKETA DOLOMITE WITHIN 1'
MINUS OF THE DAHLSTEN #3. WE HOPE THE INFORMATION WILL
FILL YOUR REQUIREMENTS.

VERY TRULY YOURS,

David Litan

PLUGGING
FILE SEC 25 T 15 R 4W
BOOK PAGE 20 LINE 19

RECEIVED
STATE CORPORATION COMMISSION
MAY 11 1954
CONSERVATION DIVISION
Wichita, Kansas

WELL LOG BUREAU MEMBERS OF GEOLOGICAL SOCIETY
 500 East Main, Wichita, Kansas


15-169-00733-0000

Company- W. G. BRUNS
 Farm- Dahlsten No. 1

SEC. 25 T. 15 R. 1W
 NE NE NW

Total Depth. 3432
 Comm. 5-26-51 Comp. 6-7-51
 Shot or Treated.
 Contractor.
 Issued. 5-17-52

County Saline
 KANSAS

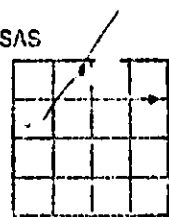

CASING
 8 5/8" 33' ccm w/225 sx

Elevation. 1304

Production. dry

Figures Indicate Bottom of Formations.

clay, shale	320
anhydrite	350
lime	900
lime, shale	1080
shale, shells	1800
lime, shale	2100
shale	2255
lime	2500
lime, shale	2600
lime	2690
lime, shale	2880
lime	3152
lime chalky	3155
lime	3190
shale	3275
lime, shale	3360
shale	3429
lime maquoketa	3432
Total depth	

Tops: Scout
 Mississippi 2904 (-1600)
 Kinderhook 3193
 Misener 3326
 Hurton 3332
 Maquoketa Shale 3358
 Dolomite 3428 (-2250)

PLUGGING
 FILE SEC 25 T 15 R 1W
 BOOK PAGE 20 LINE 19

RECORDED
 STATE COMMISSION

CONCEALED