

CARD MUST BE TYPED

State of Kansas  
**NOTICE OF INTENTION TO DRILL**  
(see rules on reverse side)

CARD MUST BE SIGNED

Starting Date: 7 16 1985  
month day year

API Number 15- 073-23,456-0000

SW SE SE Sec 22 Twp 22 S, Rge 11  
(location)  East  West

OPERATOR: License # 4381  
Name Patrick T. Forbes  
Address P.O. Box 528  
City/State/Zip Eureka, KS 67045  
Contact Person Richard A. Soule  
Phone (316) 583-5237

330 Ft North from Southeast Corner of Section  
990 Ft West from Southeast Corner of Section  
(Note: Locate well on Section Plat on reverse side)

CONTRACTOR: License # 5650  
Name Kilby Drilling  
City/State Yates Center, KS 66783

Nearest lease or unit boundary line 330 feet.  
County Greenwood  
Lease Name Freeburg Well# 7

Well Drilled For: Well Class: Type Equipment:  
 Oil  Swd  Infield  Mud Rotary  
 Gas  Inj  Pool Ext.  Air Rotary  
 OWWO  Expl  Wildcat  Cable

Domestic well within 330 feet:  yes  no  
Municipal well within one mile:  yes  no

If OWWO: old well info as follows:  
Operator  
Well Name  
Comp Date Old Total Depth  
Projected Total Depth 2050 feet  
Projected Formation at TD Bartlesville  
Expected Producing Formations Bartlesville

Depth to Bottom of fresh water Note 240 feet  
Lowest usable water formation  
Depth to Bottom of usable water 100 feet  
Surface pipe by Alternate: 1  2   
Surface pipe to be set 100 feet  
Conductor pipe if any required feet  
Ground surface elevation feet MSL  
This Authorization Expires 1-16-86  
Approved By 7-16-85 RCH EX KCH

I certify that we will comply with K.S.A. 55-101, et seq., plus eventually plugging hole to K.C.C. specifications.

Date 7/16/85 Signature of Operator or Agent *W. Corlies* Title


As Agent

Must be filed with the K.C.C. five (5) days prior to commencing work.  
This card void if drilling not started within six (6) months of date received by K.C.C.

RECEIVED  
STATE CORPORATION COMMISSION  
88-011-10

Important procedures to follow  
JUL 16 1985

**A Regular Section of Land**  
1 Mile = 5,280 FL

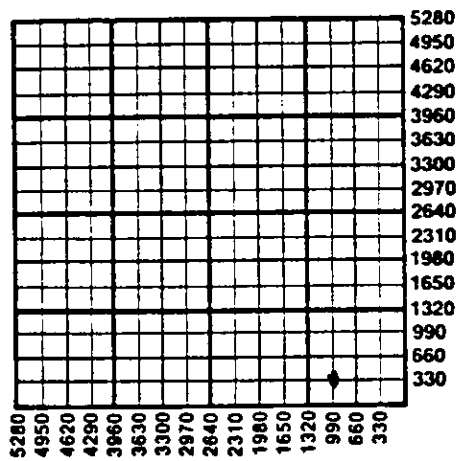

1. Notify District office before setting surface casing.
2. Set surface casing by circulating cement to the top.
3. File completion forms ACO-1 with K.C.C. within 90 days of well completion, following instructions on ACO-1, side 1, and including copies of wireline logs.
4. Notify District office 48 hours prior to old well workover or re-entry.
5. Prior to plugging, prepare a plugging plan, then obtain agreement from the appropriate district office for an approved plugging plan.
6. Submit plugging report (CP-4) to K.C.C. after plugging is completed.
7. Obtain an approved injection docket number before disposing of salt water.
8. Notify K.C.C. within 10 days when injection commences or terminates.
9. If an alternate 2 completion, cement in the production pipe from below any usable water to surface within 120 days of spud date.

CONSERVATION DIVISION  
Wichita, Kansas

State Corporation Commission of Kansas  
Conservation Division  
200 Colorado Derby Building  
Wichita, Kansas 67202  
(316) 263-3238