

EFFECTIVE DATE: 12-2-90

15.121-27091-000

FORM MUST BE TYPED
FORM C-1 4/90

State of Kansas
NOTICE OF INTENTION TO DRILL

FORM MUST BE SIGNED
ALL BLANKS MUST BE FILLED

Must be approved by the K.C.C. five (5) days prior to commencing well

Expected Spud Date: 12/01/90 month day year
SW NW SE Sec 04 Twp 18 S Rg 23 EE East West

OPERATOR: License # 8267
..... 1698 feet from South Line of Section
..... 2082 feet from East Line of Section
(Note: Locate well on Section Plat on Reverse Side)

Name: TUCKER, DANIEL D.
Address: 7801 W. 64th Street
City/State/Zip: OVERLAND PARK KS 66202 County: MIAMI
Contact Person: DANIEL C. TUCKER Lease Name: PECKMAN Well# 7
Phone: (913) 677-0523 Field Name: PAOLA

CONTRACTOR: License # 6142 Is this a Prorated Field? yes XX no
Name: TOWN OIL COMPANY Target Formation(s): PERU-SAND

Well Drilled For: Well Class: Type Equipment:
XX Oil Inj XX Infield XX Mud Rotary
.... Gas Storage Pool Ext Air Rotary
.... OWWO Disposal Wildcat Cable
.... Seismic; # of Holes
Domestic well within 330 feet: yes XX no
Municipal well within one mile: yes XX no
Depth to bottom of fresh water: 40
Depth to bottom of usable water: 200
Surface Pipe by Alternate: 1 XX 2
Length of Surface Pipe Planned to be set: 20
Length of Conductor Pipe required: *****
Projected Total Depth: 350
Formation at Total Depth: PERU-SAND
Water Source for Drilling Operations:
..... well farm pond XX other

If OWWO, old well information as follows:
Operator:
Well Name:
Comp Date: Old Total Depth:
DWR Permit#
Directional, Deviated or Horizontal Wellbore? yes XX no Will Cores Be Taken? XX yes no
If yes, total depth location: If yes, proposed zone: PERU-SAND

AFFIDAVIT

The undersigned hereby affirms that the drilling, completion and eventual plugging of this well will comply with K.S.A. 55-101, et. seq.

- It is agreed that the following minimum requirements will be met:
1. The appropriate district office shall be notified before setting surface pipe;
 2. The minimum amount of surface pipe as specified above shall be set by circulating cement to the top; in all cases surface pipe shall be set through all unconsolidated materials plus a minimum of 20 feet into the underlying formation;
 3. If the well is dry, a plugging proposal shall be submitted to the district office. An agreement between the operator and the district office on plug length and placement is necessary prior to plugging;
 4. The appropriate district office will be notified before well is either plugged or production casing is cemented in;
 5. If an Alternate II completion, production pipe shall be cemented from below any usable water to surface within 120 days of spud date. In all cases, notify district office prior to any cementing.

I hereby certify that the statements made herein are true and to the best of my knowledge and belief.
Date: 11/26/90 Signature of Operator or Agent: Holly Guinard Title: AS AGENT

FOR KCC USE:
API # 15- 121-27,091
Conductor Pipe required None feet
Minimum surface pipe required 20 feet per Alt. 2
Approved by: 11-27-90
EFFECTIVE DATE: 12-2-90
This authorization expires: 3-27-91
(This authorization void if drilling not started within 6 months of effective date.)
Spud date: _____ Agent: _____

NOV 26 1990
CONSERVATION DIVISION
Wichita, Kansas
APPLICANT'S SIGNATURE
WICHTA, KANSAS

REMEMBER TO:

- File Drill Pit Application (form CDP-1) with Intent to Drill;
- File Completion Form ACO-1 within 120 days of spud date;
- File acreage attribution plat according to field proration orders;
- Notify appropriate district office 48 hours prior to workover or re-entry;
- Submit plugging report (CP-4) after plugging is completed;
- Obtain written approval before disposing or injecting salt water.

Mail to: Conservation Division, 200 Colorado Derby Building, 202 W. First St., Wichita, Kansas 67202-1286

W
T
M
N

4
18
23E

PLAT OF ACREAGE ATTRIBUTABLE TO A WELL


State Corporation Commission, Conservation Division
200 Colorado Derby Bldg. Wichita, Kansas 67202

OPERATOR TUCKER, DANIEL D. LOCATION OF WELL:
 LEASE PECKMAN 1698 feet north of SE corner
 WELL NUMBER 7 2082 feet west of SE corner
 FIELD PAOLA SE Sec. 04 T 18 R 23 E
 COUNTY MIAMI
 NO. OF ACRES ATTRIBUTABLE TO WELL _____ IS SECTION REGULAR IRREGULAR?
 DESCRIPTION OF ACREAGE SE CORNER BOUNDARY.
 IF IRREGULAR, LOCATE WELL FROM NEAREST

NOTE: If plat depicted is insufficient for your circumstances, you may attach your own scaled or surveyed plat.

*non-prorated field

PLAT

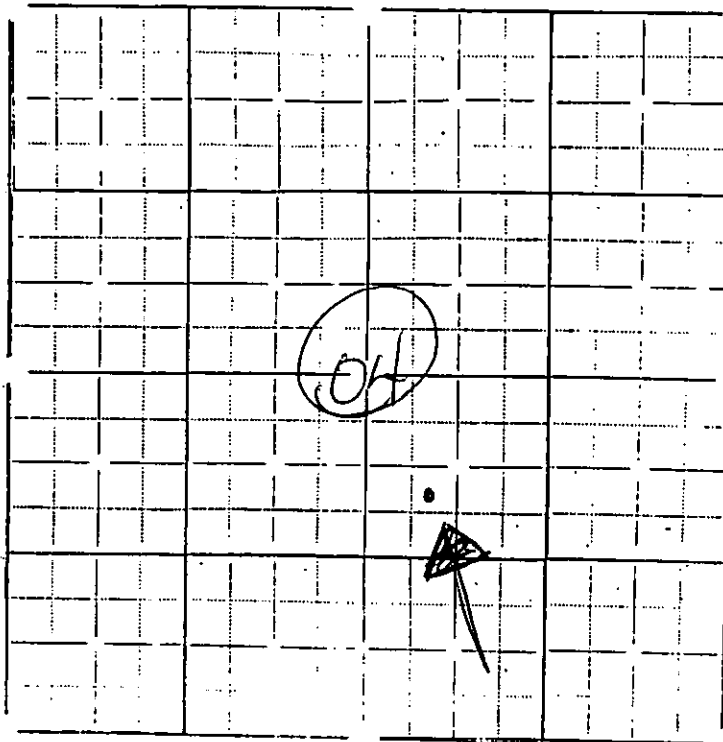

In plotting the proposed location of the well, you must show:

- 1) The manner in which you are using the depicted plat by identifying section lines, i.e. 1 section, 1 section with 8 surrounding partial sections, 4 sections, 16 sections, etc.;
- 2) the well's location relative to the location of other wells producing from the same common source of supply in adjoining drilling units, pursuant to K.A.R. 82-3-108, 82-3-207, 82-3-312, or special orders of the Commission;
- 3) the distance of the proposed drilling location from the section's east and south lines; and
- 4) the distance to the nearest lease or unit boundary line.

I hereby certify that the statements made herein are true and to the best of my knowledge and belief.

Signature of Operator or Agent Holly Guinard
 Title SEARCH, INC.

Date 11/26/90