


WELL PLUGGING RECORD

Give All Information Completely
Make Required Affidavit
Mail or Deliver Report to:
Conservation Division
State Corporation Commission
212 North Market, Insurance Bldg.
Wichita, Kansas

Saline County, Sec. 10 Twp. 15 Rge. 1 (E) (W)
Location as "NE/CNWxSWx" or footage from lines. CW/2 NE NE
Lease Owner Don McKeller
Lease Name Jackman Well No. No. 3
Office Address 812 Hancock St., Salina, Kansas
Character of Well (completed as Oil, Gas or Dry Hole) Dry Hole
Date well completed 30 November 19 60
Application for plugging filed 30 November 19 60
Application for plugging approved 30 November 19 60
Plugging commenced 30 November 19 60
Plugging completed 30 November 19 60
Reason for abandonment of well or producing formation Dry Hole

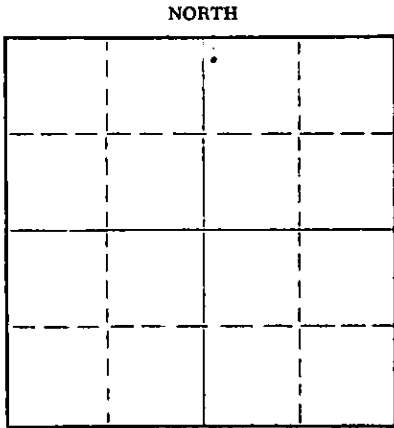

Locate well correctly on above Section Plat

If a producing well is abandoned, date of last production 19
Was permission obtained from the Conservation Division or its agents before plugging was commenced?

Name of Conservation Agent who supervised plugging of this well Gilbert Toman
Producing formation Depth to top Bottom Total Depth of Well Feet
Show depth and thickness of all water, oil and gas formations.

OIL, GAS OR WATER RECORDS

CASING RECORD

FORMATION	CONTENT	FROM	TO	SIZE	PUT IN	PULLED OUT
				8 5/8"	128	
				4 1/2"	2547"	

Describe in detail the manner in which the well was plugged, indicating where the mud fluid was placed and the method or methods used in introducing it into the hole. If cement or other plugs were used, state the character of same and depth placed, from feet to feet for each plug set.

Filled hole with heavy mud to 115 feet and put in sack of Hulls and plug and 20 sacks of cement through drill pipe.
Filed hole to 35' and put in sack of hulls plug and 10 sacks of cement.

DEC 12-12-60

(If additional description is necessary, use BACK of this sheet)

Name of Plugging Contractor Duke Burt Drilling Co.
Address Great Bend, Kansas

STATE OF Kansas, COUNTY OF Barton, ss.
Duke C. Burt (employee of owner) or (owner or operator) of the above-described well, being first duly sworn on oath, says: That I have knowledge of the facts, statements, and matters herein contained and the log of the above-described well as filed and that the same are true and correct. So help me God.

(Signature) Duke C. Burt
Great Bend, Kansas
(Address)

SUBSCRIBED AND SWORN TO before me this 9th day of December, 19 60

My commission expires September 29, 1963

Dexter Miller
Notary Public.



WELL LOG BUREAU—KANSAS GEOLOGICAL SOCIETY
508 East Murdock, Wichita, Kansas

COPY


Company- DON McKELLAR
Farm- Jackman No. 3

SEC. 10 T. 15 R. 1W
C W/2 NE NE

Total Depth. 2548'
Comm. 12-4-60 Comp. 12-11-60
Shot or Treated.
Contractor. Duke Burt Drig.
Issued. 4-22-61

County Saline

KANSAS

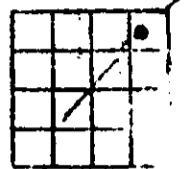

Elevation. 1235' GL

Production. Dry

Figures Indicate Bottom of Formations.

surface clay & shale	70
shale & lime	120
lime	180
lime & shale	1795
lime	2200
lime & shale	2515
lime (Mississippi)	2548
Total Depth	

TOPS: SCOUT	
Brown Lime	1839
Lansing	1890
Base Kansas City	2226
Mississippi	2537

RECEIVED
STATE CORPORATION COMMISSION
MAY 2 1968
CONSERVATION DIVISION
Wichita, Kansas