

Corrected location

STATE OF KANSAS
STATE CORPORATION COMMISSION


Form CP-4

Give All Information Completely
Make Required Affidavit
Mail or Deliver Report to:
Conservation Division
State Corporation Commission
211 No. Broadway
Wichita, Kansas

WELL PLUGGING RECORD

Saline County. Sec. 11 Twp. 15 Rge. (E) 1 (W)
Location as "NE/CNWKSWK" or footage from lines NW NW SW
Lease Owner F. S. Williams
Lease Name McLin Well No. 1
Office Address McPherson, Kansas
Character of Well (completed as Oil, Gas or Dry Hole) Dry Hole
Date well completed 12/11 19 59
Application for plugging filed " 19 59
Application for plugging approved " 19 59
Plugging commenced " 19 59
Plugging completed " 19 59
Reason for abandonment of well or producing formation Dry Hole

NORTH

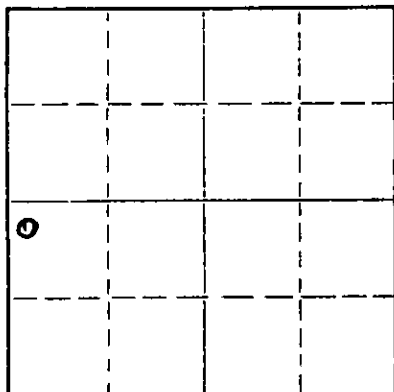

Locate well correctly on above Section Plat

If a producing well is abandoned, date of last production 19
Was permission obtained from the Conservation Division or its agents before plugging was commenced? yes

Name of Conservation Agent who supervised plugging of this well Gilbert Toman
Producing formation _____ Depth to top _____ Bottom _____ Total Depth of Well 2592 Feet
Show depth and thickness of all water, oil and gas formations.

OIL, GAS OR WATER RECORDS

CASING RECORD

FORMATION	CONTENT	FROM	TO	SIZE	PUT IN	PULLED OUT
				8 5/8"	124'	none

Describe in detail the manner in which the well was plugged, indicating where the mud fluid was placed and the method or methods used in introducing it into the hole. If cement or other plugs were used, state the character of same and depth placed, from _____ feet to _____ feet for each plug set.

2592' to 120' with heavy mud
wooden plug & 1/2" x hulls @ 120'
20sx of cement on plug
mud to 40'
wooden plug & 1/2" x hulls @ 40'
10sx cement on plug
surface soil to 0'

6-10-66

(If additional description is necessary, use BACK of this sheet)

Name of Plugging Contractor Melland Drilling Co., Inc.
Address Box 783, McPherson, Kansas

STATE OF Kansas, COUNTY OF McPherson, ss.
Donald J. Melland (employee of owner) or (owner) of the above-described well, being first duly sworn on oath, says: That I have knowledge of the facts, statements, and matters herein contained and the log of the above-described well as filed and that the same are true and correct. So help me God.

(Signature) Donald J. Melland
Box 783, McPherson, Kansas
(Address)

SUBSCRIBED AND SWORN TO before me this 7th day of June, 19 66

My commission expires December 23, 1967 Notary Public.

LEASE: No. 41

Well No. 1

15-169-00163-0000

LOCATION: NW/4 NW/4 SW/4
 Section 22-15-9-11-15-1W
 Saline County, Kansas

COMPLETION: 12/5/59

COMPLETION: 12/11/59

OPERATOR: P. E. Williams
 McPherson, Kansas

CONTRACTOR: Holland Drilling Company, Inc.
 1111 North Main Street
 Hutchinson, Kansas

CASING LOGGED: 4-5/8" CD casing set at 124' with 100 sacks of cement and 1 sack of calcium chloride.

FORMATION	LOG
Surface soil & clay	20
White rock	60
Shale & shells	90
Anhydrite	165
Gypsum, shale & shells	260
Lime, shale & shells	308
Lime w/ shale streaks	505
Lime & shale	810
Shale w/ lime	930
Shale & shells	1360
Shale & lime	1610
Lime w/ shale streaks	1769
Sand	1920
Lime & shale	2280
Shale & lime	2568
Mississippi Lime	2592

ROTA. Y TOTAL DEPTH

Flugged back from 2592' to 120' with heavy mud. Set wood plug at 120' with 1/2 sack of balls. Flugged back from 120' to 58' with 20 sacks of cement. Flugged back from 58' to 40' with heavy mud. Set wood plug at 40' with 1/2 sack of balls. Flugged back from 40' to 6' with 10 sacks of cement. Flugged back with surface soil from 6' to 0'. Flugged and abandoned December 11, 1959.

RECEIVED
 OILS DEPARTMENT COMMISSIONER

JUN 10 1966