


Give All Information Completely  
Make Required Affidavit  
Mail or Deliver Report to:  
Conservation Division  
State Corporation Commission  
212 North Market, Insurance Bldg.  
Wichita, Kansas

WELL PLUGGING RECORD

Saline County. Sec. 11 Twp. 15S Rge. 1 (#) 1 (W)  
Location as "NE/CNW/SWK" or footage from lines SW NW NW  
Lease Owner Don Mc Kellar  
Lease Name Daisy Heath Well No. 2  
Office Address 812 Hancock St. Salina, Kansas  
Character of Well (completed as Oil, Gas or Dry Hole) Dry  
Date well completed March 27 19 60  
Application for plugging filed " 19 60  
Application for plugging approved " ORAL 19 60  
Plugging commenced " 19 60  
Plugging completed " 19  
Reason for abandonment of well or producing formation \_\_\_\_\_

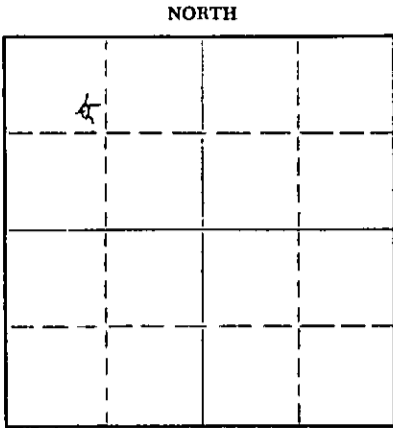

Locate well correctly on above Section Plat

If a producing well is abandoned, date of last production \_\_\_\_\_ 19\_\_\_\_  
Was permission obtained from the Conservation Division or its agents before plugging was commenced? \_\_\_\_\_

Name of Conservation Agent who supervised plugging of this well Mr. Toman Holyrood, Kansas  
Producing formation \_\_\_\_\_ Depth to top \_\_\_\_\_ Bottom \_\_\_\_\_ Total Depth of Well 2595 Feet  
Show depth and thickness of all water, oil and gas formations.

OIL, GAS OR WATER RECORDS

CASING RECORD

FORMATION	CONTENT	FROM	TO	SIZE	PUT IN	PULLED OUT
				8 5/8	125 ft.	none

Describe in detail the manner in which the well was plugged, indicating where the mud fluid was placed and the method or methods used in introducing it into the hole. If cement or other plugs were used, state the character of same and depth placed, from \_\_\_\_\_ feet to \_\_\_\_\_ feet for each plug set.

Filled hole full heavy mud to 125 ft.  
Drove wooden plug to 125 ft and dumped  
in 15 sacks cement. Finished filling hole full  
heavy mud to within 40 ft. of cellar and dumped in  
5 sacks cement.

RECEIVED  
STATE CORPORATION COMMISSION  
MAR 29 1960  
3-29-60  
CONSERVATION DIVISION  
Wichita, Kansas

(If additional description is necessary, use BACK of this sheet)

Name of Plugging Contractor \_\_\_\_\_  
Address \_\_\_\_\_

STATE OF Kansas COUNTY OF Sedgwick, ss.  
C. C. Nelson, partner Mallard Drg. (employee of owner) or (owner or operator) of the above-described well, being first duly sworn on oath, says: That I have knowledge of the facts, statements, and matters herein contained and the log of the above-described well as filed and that the same are true and correct. So help me God.

(Signature) C. C. Nelson X  
419 Union Natl. Bldg.  
(Address)

SUBSCRIBED AND SWORN TO before me this 27th day of March, 19 60

My commission expires March 12, 1962  
Edward D. Sarge  
Notary Public.

COMPANY: Don Mc Kellar  
 CONTRACTOR: Mallard Drilling Company  
 FARM: Daisy Heath #2  
 LOCATION: SW NW NW Sec. 11-15S-1W  
 Saline County, Kansas  
 COMMENCED: March 21, 1960  
 COMPLETED: March 27, 1960

0	to	30	Shale
30	to	125	Lime and shells
125	to	555	Lime
555	to	1215	Shale and shells
1215	to	1490	Shale and lime
1490	to	1874	Lime and shale
1874	to	1924	Br. Lime
1924	to	1940	Kc. Lime
1940	to	2260	Lime
2260	to	2475	Shale and lime
2475	to	2585	Shale and lime
2585	to	2595	Mississippi
		2595	T.D.

RECEIVED  
 STATE CORPORATION COMMISSION  
 MAR 29 1960  
 CONSERVATION DIVISION  
 Wichita, Kansas

Set 125 ft. of 8 5/8" surface pipe. Cemented with 90 sacks cement.

TOPS: m MISSISSIPPI -- 2585

Measurements taken from R.D.B. R.D.B. 5 1/2 ft. from ground level.  
 DRY, ABANDONED AND PLUGGED

C E R T I F I C A T E

I, C. C. Nelson, do hereby certify that the above and foregoing is a true and correct copy of log of the Daisy Heath #2, Saline County, Kansas as reflected by files of Mallard Drilling Company.

C. C. Nelson

Subscribed and sworn to before me a Notary Public, within and for Sedgwick County, Kansas, this 29th day of March 1960.

E. W. D. Saye

My commission expires March 12, 1960