

This form shall be filed in duplicate with the Kansas Corporation Commission, 200 Colorado Derby Building, Wichita, Kansas 67202, within ten days after the completion of the well, regardless of how the well was completed.

Attach separate letter of request if the information is to be held confidential. If confidential, only file one copy. Information on side one will be of public record and side two will then be held confidential.

Circle one: Oil, Gas, Dry, SWD, OWWO, Injection. Type and complete ALL sections.

Applications must be filed for dual completion, commingling, SWD and injection, T.A.

Attach wireline logs (i.e. electrical log, sonic log, gamma ray neutron log, etc.).

KCC # (316) 263-3238. (Rules 82-2-105 & 82-2-125)

OPERATOR Teichgraeber Oil Operations

API NO. 15-169 20,118 -0000

ADDRESS Box 471

COUNTY Saline

El Dorado, KS 67042

FIELD Smolan

**CONTACT PERSON R. K. Teichgraeber

PROD. FORMATION Maquoketa Dolomite

PHONE 316, 321, 2770

LEASE Ryding

PURCHASER Temporarily abandoned

WELL NO. 2

ADDRESS

WELL LOCATION E/2 NW SW

660 Ft. from North Line and

950 Ft. from West Line of

the SEC. 36 TWP. 15 RGE. 4W


DRILLING EDCO Drilling

CONTRACTOR

ADDRESS Box 645

El Dorado, KS 67042

WELL PLAT

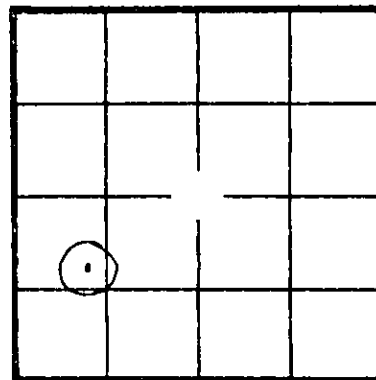

KCC [check]
KGS [check]
(Office Use)

PLUGGING

CONTRACTOR

ADDRESS

TOTAL DEPTH 3459 PBDT 3450

SPUD DATE 12/12/80 DATE COMPLETED 12/16/80

ELEV: GR DF KB 1325

DRILLED WITH (CABLE) (ROTARY) (AIR) TOOLS

Amount of surface pipe set and cemented 320' DV Tool Used?

AFFIDAVIT

RECEIVED
STATE CORPORATION COMMISSION
1-15-82
JAN 15 1982

STATE OF Kansas, COUNTY OF Butler

R. K. Teichgraeber OF LAWFUL AGE, BEING FIRST DULY SWORN/UPON HIS OATH,

DEPOSES THAT he is the OPERATOR OF THE Ryding LEASE, AND IS DULY AUTHORIZED TO MAKE

THIS AFFIDAVIT FOR THE BEHALF OF SAID OPERATOR, THAT WELL NO. 2 ON

SAID LEASE HAS BEEN COMPLETED AS OF THE 16th DAY OF December, 19 80, AND THAT

ALL INFORMATION ENTERED HEREIN WITH RESPECT TO SAID WELL IS TRUE AND CORRECT.

FURTHER AFFIANT SAITH NOT.

SUBSCRIBED AND SWORN BEFORE ME THIS 14 DAY OF January, 19 82.

(S) R. K. Teichgraeber

Notary Public signature: Hazel B. Lynch

NOTARY PUBLIC HAZEL B. LYNCH
STATEWIDE SECRETARY
BUTLER COUNTY, KANSAS

MY COMMISSION EXPIRES: Sept. 16 1982

**The person who can be reached by phone regarding any questions concerning this information. Within 45 days of completion, a witnessed initial test by the Commission is required if the well produces more than 25 BOPD or is located in a Basic Order Pool.