


Give All Information Completely  
Make Required Affidavit  
Mail or Deliver Report to:  
Conservation Division  
State Corporation Commission  
211 No. Broadway  
Wichita, Kansas

WELL PLUGGING RECORD

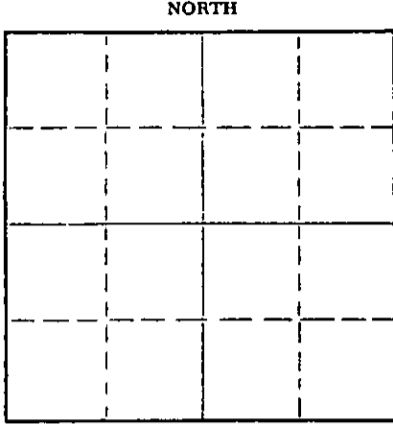

Locate well correctly on above  
Section Plat

Saline County, Sec. 19 Twp. 15S Rge. (E) 1 (W)  
Location as "NE/CNW/SW" or footage from lines C SE NW  
Lease Owner Ohio Oil Company  
Lease Name C. C. Shoffner Well No. 1  
Office Address Enterprise Bldg., Tulsa, Oklahoma  
Character of Well (completed as Oil, Gas or Dry Hole) Dry Hole  
Date well completed 8/31 1958  
Application for plugging filed 8/31 1958  
Application for plugging approved 8/31 1958  
Plugging commenced 8/31 1958  
Plugging completed 8/31 1958  
Reason for abandonment of well or producing formation Dry Hole

If a producing well is abandoned, date of last production 19  
Was permission obtained from the Conservation Division or its agents before plugging was commenced? Yes

Name of Conservation Agent who supervised plugging of this well Gene Graham, Winfield, Kansas  
Producing formation \_\_\_\_\_ Depth to top \_\_\_\_\_ Bottom \_\_\_\_\_ Total Depth of Well 3615 Feet  
Show depth and thickness of all water, oil and gas formations.

OIL, GAS OR WATER RECORDS

CASING RECORD

FORMATION	CONTENT	FROM	TO	SIZE	PUT IN	PULLED OUT
				9-5/8"	203'	None

Describe in detail the manner in which the well was plugged, indicating where the mud fluid was placed and the method or methods used in introducing it into the hole. If cement or other plugs were used, state the character of same and depth placed, from \_\_\_\_\_ feet to \_\_\_\_\_ feet for each plug set.

Wooden plug with 1/2 sack hulls at 195' and 15 sacks cement.  
Another plug, 1/2 sack hulls and 10 sacks cement at 40'.

(If additional description is necessary, use BACK of this sheet)

Name of Plugging Contractor Greenland Drilling Company  
Address 4722 Broadway, Kansas City 12, Mo.

STATE OF Kansas, COUNTY OF Sedgwick, ss.  
Oscar Bridge (employee of owner) or (owner or operator) of the above-described well, being first duly sworn on oath, says: That I have knowledge of the facts, statements, and matters herein contained and the log of the above-described well as filed and that the same are true and correct. So help me God.

(Signature) Oscar Bridge  
Oscar Bridge, Vice-President Greenland Drilling Co.  
4722 Broadway, Kansas City 12, Mo.  
(Address)

SUBSCRIBED AND SWORN TO before me this 2nd day of September, 1958

Verlina B. Rutledge  
Notary Public.

My commission expires March 15, 1960

STAT. 7  
9-4-58  
CO

PLUGGING  
FILE SEC. 19 T15 R1W  
BOOK PAGE 127 LINE 31

15169-00140-0000

WELL LOG

Company: OHIO OIL COMPANY

Sec. 19 Twp. 15S Rge. 1W

Farm: C. C. SHOFFNER No. 1

Location: C SE NW

Saline County, Kansas

Commenced: 8-18-58

Completed: 8-31-58

Total Depth: 3615

Contractor: GREENLAND DRILLING COMPANY

Casing: 9-5/8" 203'

Elevation: 1352 R.B.

5-1/2" ---

Production: D &amp; A

## Figures Indicate Bottom of Formations

120	Shale & shells	TOPS:	
203	Lime & shale	Topeka	1621
400	Lime & shale	Heebner	1902
510	Shale & lime w/red bed s streaks	Brown Lime	2051
1600	Shale & lime	Lansing	2122
1732	Lime & shale	Mississippi	2788
1797	Shale & lime	Kinderhook	3056
1862	Lime & shale	Hunton	3184
2046	Shale & lime	Maquoketa	3304
2048	Brown Lime	Viola	3403
2062	Shale & lime	Simpson	3509
2124	Lime & shale	Arbuckle	3569
2195	Lime	RTD	3615
2433	Lime & shale		
2658	Shale & lime		
2745	Shale		
2874	Lime & shale		
2975	Mississippi		
3004	Shale & lime		
3018	Lime & shale		
3040	Kinderhook shale		
3055	Lime		
3165	Shale		
3191	Shale & lime		
3318	Lime		
3379	Shale & lime		
3404	Shale		
3503	Viola		
3562	Simpson		
3615	Arbuckle		
3615	RTD		

STATE OF KANSAS, COUNTY OF SEDGWICK, ss:


I, Oscar Bridge, of the Greenland Drilling Company, upon oath state that the above and foregoing is a true and correct copy of the log of the #1 C.C. Shoffner well.

*Oscar Bridge*  
 Oscar Bridge, Vice-President

Subscribed and sworn to before me this 2nd day of September, 1958.

*Verdina B. Rutledge*  
 Verdina B. Rutledge, Notary Public

My commission expires March 15, 1960.

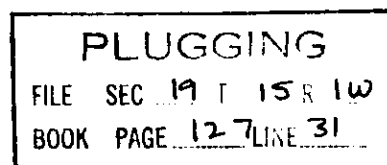

SEARCHED  
 INDEXED  
 DIVISION  
 has