

15/69-00803-0000

STATE OF KANSAS
STATE CORPORATION COMMISSION


WELL PLUGGING RECORD

Give All Information Completely
Make Required Affidavit
Mail or Deliver Report to:
Conservation Division
State Corporation Commission
800 Biting Building
Wichita, Kansas

OR
FORMATION PLUGGING RECORD

Strike out upper line
when reporting plug-
ging off formations.

Saline County. Sec. 34 Twp. 15 Rge. (H) 1 (W)
Location as "NE $\frac{1}{4}$ NW $\frac{1}{4}$ SW $\frac{1}{4}$ " or footage from lines. SE SE SW
Lease Owner. W. R. Wilson
Lease Name. Karber Well No.
Office Address. 3619 Forest Avenue K. C. Mo.
Character of Well (completed as Oil, Gas or Dry Hole). Dry hole
Date well completed. x October 3, 19. 47
Application for plugging filed. x February 18, 19. 48
Application for plugging approved. 2-20-48 19.
Plugging commenced. x 19.
Plugging completed. x 19.
Reason for abandonment of well or producing formation. dropped 5" pipe
If a producing well is abandoned, date of last production. x 19.
Was permission obtained from the Conservation Division or its agents before plugging was com-
menced? Yes

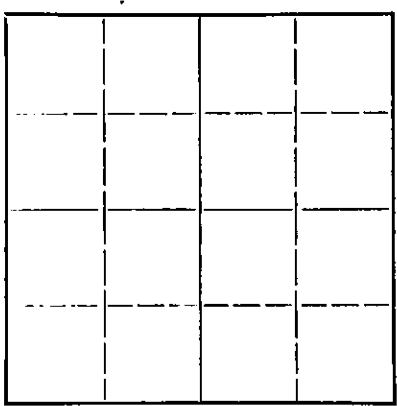

Locate well correctly on above
Section Plat

Name of Conservation Agent who supervised plugging of this well. Ruel Durkee
Producing formation. x Depth to top. x Bottom. x Total Depth of Well. 2685 Feet
Show depth and thickness of all water, oil and gas formations.

OIL, GAS OR WATER RECORDS

CASING RECORD

Formation	Content	From	To	Size	Put In	Pulled Out
No log available				20"	60'	L I
				15	150	130
				12 $\frac{1}{2}$	750	750
				8	2000	2000
				6	2400	2400
				5	2550	2550

Describe in detail the manner in which the well was plugged, indicating where the mud fluid was placed and the method or methods used in introducing it into the hold. If cement or other plugs were used, state the character of same and depth placed, from.....feet to.....feet for each plug set.

Hole filled with mud to 210
Rock from 210 to 200
30 Sx of cement dumped at 200
Mud to top
10 sa x cement at base of cellar

9-16-48

(If additional description is necessary, use BACK of this sheet)

Correspondence regarding this well should be addressed to.....
Address.....

STATE OF Kansas, COUNTY of McPherson, W. E. Lehmburg Receiver, ss.
(employee of owner) or (owner or operator) of the above-described well,
being first duly sworn on oath, says: That I have knowledge of the facts, statements, and matters herein contained and the log of the above-described well as filed and that the same are true and correct. So help me God.

(Signature) *W. E. Lehmburg*
McPherson, Kansas
(Address)

SUBSCRIBED AND SWORN to before me this 15 day of Sept, 19 48
Quich Nelson
Notary Public.

My commission expires January 10, 1949

