


STATE OF KANSAS
STATE CORPORATION COMMISSION

Form CP-4

WELL PLUGGING RECORD

Give All Information Completely
Make Required Affidavit
Mail or Deliver Report to:
Conservation Division
State Corporation Commission
212 No. Market
Wichita, Kansas 67202

NORTH

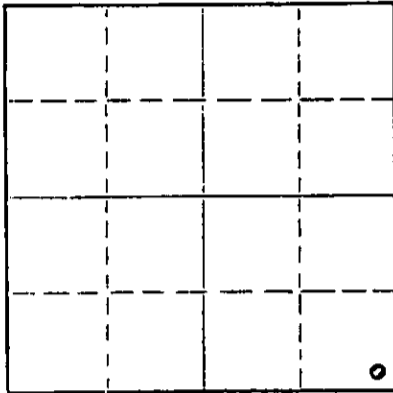

Locate well correctly on above
Section Plat

Saline County, Sec 27 Twp. 15 Rge. 1 (W)
Location as "NE/CNW/SW" or footage from lines SE SE SE
Lease Owner Melland Drilling, Inc.
Lease Name Schwarz Well No. 1
Office Address 901 N. Main, McPherson, Kansas 67460
Character of Well (completed as Oil, Gas or Dry Hole) Dry Hole
Date well completed December 22 19 71
Application for plugging filed 19
Application for plugging approved 19
Plugging commenced 19
Plugging completed December 22, 19 71
Reason for abandonment of well or producing formation Dry Hole

If a producing well is abandoned, date of last production 19
Was permission obtained from the Conservation Division or its agents before plugging was commenced? Yes

Name of Conservation Agent who supervised plugging of this well Gilbert Toman
Producing formation Depth to top Bottom Total Depth of Well Feet
Show depth and thickness of all water, oil and gas formations.

OIL, GAS OR WATER RECORDS

CASING RECORD

FORMATION	CONTENT	FROM	TO	SIZE	PUT IN	PULLED OUT
Shale		0	70	8 5/8"	70'	None
Lime		70	128	8 5/8"	58'	"

Describe in detail the manner in which the well was plugged, indicating where the mud fluid was placed and the method or methods used in introducing it into the hole. If cement or other plugs were used, state the character of same and depth placed, from feet to feet for each plug set.

Filled hole with mud to 125' & set plug with 25 sacks of cement.
Filled to 40' & set plug with 10 sacks of cement, 2 sacks in
rathole. Plugging completed at 4:00 A. M., December 22, 1971.
State Pluggger, Gilbert Toman, Holyrood, Kansas.

RECEIVED
STATE CORPORATION COMMISSION
DEC 29 1971
CONSERVATION DIVISION
Wichita, Kansas

(If additional description is necessary, use BACK of this sheet)

Name of Plugging Contractor Blackstone Drilling, Inc.
Address Box 455, McPherson, Kansas 67460

STATE OF Kansas, COUNTY OF McPherson, ss.
Melland Drilling, Inc. (employee of owner) or (owner of well) of the above-described well, being first duly sworn on oath, says: That I have knowledge of the facts, statements, and matters herein contained and the log of the above-described well as filed and that the same are true and correct. So help me God.

(Signature) by: [Signature] Melland Drilling, Inc.
901 N. Main, McPherson, Kansas 67460
(Address)

SUBSCRIBED AND SWORN TO before me this 27 day of December, 1971

My commission expires

JAMES A. SCHERER
NOTARY PUBLIC
McPherson County, Ks.
My Commission Expires
May 7, 1972

Notary Public.

15:169 20653-0000

Blackstone Drilling, Inc.

Box 455 • 523 West Kansas • Phone CH 1-1250

McPHERSON, KANSAS 67460

December 22, 1971

COMPANY: WELAND DRILLING COMPANY
CONTRACTOR: BLACKSTONE DRILLING, INC.
FARN: SCHWARTZ #1
LOCATION: SE SE SE, Sec. 27-188-1W,
Saline County, Kansas
COMMENCED: December 16, 1971
COMPLETED: December 22, 1971
ELEVATION: 1280 K. B.

0	to	70	Shale
70	to	780	Lime
780	to	1620	Shale & Lime
1620	to	1725	Lime
1725	to	1900	Lime & Shale
1900	to	1949	Lime
1949	to	1999	Brown Lime
1999	to	2075	Lansing
2075	to	2428	Lime
2428	to	2647	Lime & Shale
2647	to	2672	Mississippi
		2672	T. D.

RECEIVED
STATE CORPORATION COMMISSION
DEC 29 1971
CONSERVATION DIVISION
Wichita, Kansas

Cut 12 1/8 inch hole to 128 ft. and run 130.45 ft. of 2 5/8 inch surface pipe, cemented with 100 sacks at 128 ft., plug down at 1:30 P. M., December 17, 1971. Cut 7 7/8 inch hole to 2672 ft. Hole dry and abandoned. Filled with mud to 125 ft. and set plug with 25 sacks of cement. Filled with mud to 40 ft. and set plug with 10 sacks of cement. 2 sacks of cement in annular. Plugging completed at 4:00 A. M., December 22, 1971. Plugging completed by State Plugger, Gilbert Tomlin, Holyrood, Kansas.

TOPS: BROWN LIME - 1949' LANSING - 1999' MISSISSIPPI - 2647'

Measurements taken from K. B.

CERTIFICATE

I, H. J. Plouffe, President of Blackstone Drilling, Inc. do hereby certify that the above and foregoing is a true and correct copy of log on your SCHWARTZ #1, located on the SE SE SE, Sec. 27-188-1W, Saline County, Kansas as reflected by the files of Blackstone Drilling, Inc.

H. J. Plouffe
H. J. Plouffe, President

Subscribed and sworn to before me a Notary Public in and for McPherson County, Kansas this 22nd day of December, 1971.

Jehnnie L. Schaldt
Jehnnie L. Schaldt - Notary Public



Commission Expires: June 27, 1973.