


15-169-0025 2-0000

STATE OF KANSAS
STATE CORPORATION COMMISSION
Give All Information Completely
Make Required Affidavit
Mail or Deliver Report to:
Conservation Division
State Corporation Commission
211 No. Broadway
Wichita, Kansas

Form CP-4

WELL PLUGGING RECORD

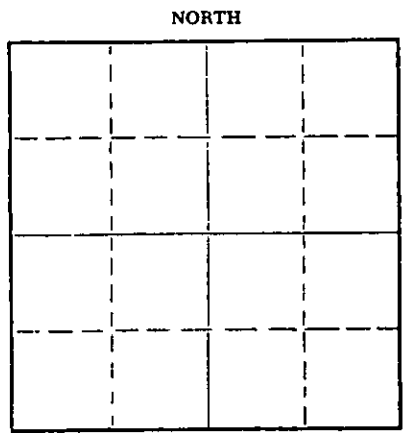

Locate well correctly on above Section Plat

Saline County, Sec. 27 Twp. 15 Rge. 1 W (E) (W)
Location as "NE/CNW&SW" or footage from lines NW NE SE
Lease Owner Cal Jones
Lease Name Schwarz Well No. I
Office Address Canton, Kansas
Character of Well (completed as Oil, Gas or Dry Hole) oil
Date well completed 11-13 19 63
Application for plugging filed Nov 19 65
Application for plugging approved Nov 19 65
Plugging commenced Nov 5 19 65
Plugging completed Nov 13 19 65
Reason for abandonment of well or producing formation

If a producing well is abandoned, date of last production 19
Was permission obtained from the Conservation Division or its agents before plugging was commenced? Gilbert Toman

Name of Conservation Agent who supervised plugging of this well
Producing formation Depth to top Bottom Total Depth of Well 2593' Feet
Show depth and thickness of all water, oil and gas formations.

OIL, GAS OR WATER RECORDS CASING RECORD

FORMATION	CONTENT	FROM	TO	SIZE	PUT IN	PULLED OUT
				4 1/2		1,742

Describe in detail the manner in which the well was plugged, indicating where the mud fluid was placed and the method or methods used in introducing it into the hole. If cement or other plugs were used, state the character of same and depth placed, from feet to feet for each plug set.

Plugged off bottom of hole with rock. Rock ffrom 2593' to 2580'. Dumped 3 sx of cement, Mudded hole to 160'. Made 10' of rock bridge. Dumped 25 sx of cement. Mudded hole to 35'. Made 5' of rock bridge. Dumped 10 sx of cement, filling to the bottom of the celler.

NOV 17 1965
11-17-65
CONSERVATION DIVISION

(If additional description is necessary, use BACK of this sheet)
Name of Plugging Contractor Art Lamb Casing Pulling Co.
Address 2809 King St. Hutchinson, Kansas

STATE OF Kansas, COUNTY OF Reno, ss.
Art Lamb (employee of owner) or (owner or operator) of the above-described well, being first duly sworn on oath, says: That I have knowledge of the facts, statements, and matters herein contained and the log of the above-described well as filed and that the same are true and correct. So help me God.

(Signature) [Signature]
2809 King Hutchinson, Kansas
(Address)

SUBSCRIBED AND SWORN TO before me this 16 th day of November, 1965

My commission expires Jan 5, 1966

[Signature] Notary Public.

WELL RECORD

15169-00252-0000

LEASE: Schwarz

WELL NO. 1

ELEVATION: 1231 RB

LOCATION: NW NW SE
Sec. 27-15-1W

COMMENCED: 11/8/63

COMPLETED: 11/13/63

OPERATOR: Cal Jones

CONTRACTOR: Melland Drilling Company, Inc.
Post Office Box 783
McPherson, Kansas

CASING RECORD: 8 5/8" @ 139'/105sx
4 1/2" @ 2592.5'/50sx

FORMATION	LOG
Shale & Shells	70
Anhydrite	139
Anhydrite & Shale	300
Lime & Shale	865
Shale & Shells	1595
Shale & Lime	1755
Sand & Shale	1873
Lime & Shale	2420
Shale & Lime	2566
Mississippi	2593
RTD	2593
Samples Tops	
Lansing	1932
Mississippian	2566
DST #1 2567-73 open 1 hr., recovered 3' oil cut mud & 30' muddy water BHP 780# & 727#	

FORMATION	LOG
-----------	-----

RECEIVED
 OIL AND GAS COMMISSION
 NOV 17 1965
 RECORDS DIVISION
 McPherson, Kansas

CERTIFICATE

State of Kansas, County of McPherson, ss.

I, Donald J. Melland, do hereby certify that the above is a true and correct copy of the log of the above named and described well, as reflected by the records of the Melland Drilling Company, Inc.

Donald J. Melland

Subscribed and sworn to before me, a Notary Public, in and for the County of McPherson, State of Kansas, this 22 day of November, 1963

My Commission expires: August 24, 1967

Jay E. Mahan
Notary Public