

STATE OF KANSAS
STATE CORPORATION COMMISSION

Form CP-4


Give All Information Completely
Make Required Affidavit
Mail or Deliver Report to:
Conservation Division
State Corporation Commission
212 No. Market
Wichita, Kansas

WELL PLUGGING RECORD

Saline County, Sec. 29 Twp. 15 Rge. 1 (E) (W) x

Location as "NE/CNWxSWx" or footage from lines. CH/2 W/2 SW
Lease Owner Frank J. Black
Lease Name King Schultz Well No. #1
Office Address Box 150, McPherson, Kansas
Character of Well (completed as Oil, Gas or Dry Hole) _____
Date well completed _____
Application for plugging filed _____
Application for plugging approved _____
Plugging commenced 7-20-70 _____
Plugging completed 7-22-70 _____
Reason for abandonment of well or producing formation _____

RECEIVED
STATE CORPORATION COMMISSION
JUL 24 1970
CONSERVATION DIVISION
Wichita, Kansas

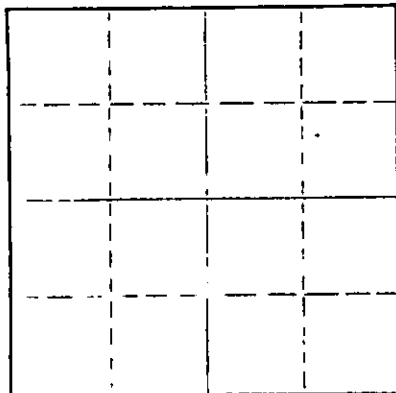

Locate well correctly on above Section Plot

If a producing well is abandoned, date of last production _____
Was permission obtained from the Conservation Division or its agents before plugging was commenced? _____

Name of Conservation Agent who supervised plugging of this well Gilbert Toman
Producing formation _____ Depth to top _____ Bottom _____ Total Depth of Well 2704' Feet
Show depth and thickness of all water, oil and gas formations.

OIL, GAS OR WATER RECORDS

CASING RECORD

FORMATION	CONTENT	FROM	TO	SIZE	PUT IN	PULLED OUT
				5 1/2"	2697'	2149.16'
				8 5/8"	134'	

Describe in detail the manner in which the well was plugged, indicating where the mud fluid was placed and the method or methods used in introducing it into the hole. If cement or other plugs were used, state the character of same and depth placed, from _____ feet to _____ feet for each plug set.

Made bottom hole plug back with sand to 2530'. Mixed and ran 5 sacks cement thru dump boiler.
Mudded hole to 140', set 10' rock bridge. Mixed and ran 25 sacks cement thru dump boiler. Mudded hole to 40', set 10' rock bridge. Mixed and dumped 10 sacks cement to base of cellar.

(If additional description is necessary, use BACK of this sheet)


Name of Plugging Contractor Southwest Casing Pulling Co.
Address Box 364, Great Bend, Kansas

STATE OF Kansas, COUNTY OF Barton, ss.
Southwest Casing Pulling Co. (employee of owner) or (owner or operator) of the above-described well, being first duly sworn on oath, says: That I have knowledge of the facts, statements, and matters herein contained and the log of the above-described well as filed and that the same are true and correct. So help me God.

(Signature) W. C. Spencer
Box 364, Great Bend, Kansas
(Address)

Subscribed and sworn to before me this 23 day of July, 19 70
Widney Miller
Notary Public.



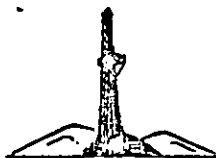

15169-20044-0000

Blackstone Drilling, Inc.

Box 455 • 523 West Kansas • Phone CH 1-1250

McPHERSON, KANSAS 67460

June 2, 1970

COMPANY: DALE REESE OIL COMPANY
 CONTRACTOR: BLACKSTONE DRILLING, INC.
 FARM: KING SCHULZ #1
 LOCATION: C W/2 W/2 SW/4, Sec. 29-15-1W
 Saline County, Kansas
 COMMENCED: May 27, 1970
 COMPLETED: June 1, 1970
 ELEVATION:

0	to	131	Shale & Shells
131	to	480	Lime & Shale
480	to	760	Lime
760	to	1205	Shale & Lime
1205	to	1580	Lime & Shale
1580	to	1930	Lime
1930	to	2119	Shale & Lime
2119	to	2425	Lime
2425	to	2585	Lime & Shale
2585	to	2674	Shale & Lime
2674	to	2704	Mississippi
		2704	T. D.

RECEIVED
 STATE CORPORATION COMMISSION
 JUL 20 1970
 CONSERVATION DIVISION
 Wichita, Kansas

Cut 12 1/4 in. hole to 131 ft. and run 134 ft. of 8 5/8 in. surface pipe, cemented with 110 sacks at 131 ft., plug down at 1:00 P. M., May 27, 1970. Cut 7 7/8 in. hole to 2704 ft. and run 2713 ft. of 5 1/2 in. pipe, cemented with 40 sacks 7 feet off bottom at 2694 ft. Plug down at 6: A. M., June 1, 1970.

TOPS: ²⁶⁹⁷ MISSISSIPPI - 2674'

Measurements taken from K. B.

CERTIFICATE

I, H. J. Plouffe, President of Blackstone Drilling, Inc. do hereby certify that the above and foregoing is a true and correct copy of log on your King Schulz #1, located on the C W/2 W/2 SW/4, Sec. 29-15-1W, Saline County, Kansas as reflected by the files of Blackstone Drilling, Inc.

H. J. Plouffe, President

Subscribed and sworn to before me a Notary Public in and for McPherson County, Kansas this 2nd day of June, 1970.

Johnnie L. Schmidt - Notary Public

My Commission Expires: June 27, 1973

