


Give All Information Completely  
Make Required Affidavit  
Mail or Deliver Report to:  
Conservation Division  
State Corporation Commission  
211 No. Broadway  
Wichita, Kansas

WELL PLUGGING RECORD

Saline County. Sec. 28 Twp 15 Rge. 1 (E) 1 (W)  
Location as "NE/CNW/SW" or footage from lines SW SW SE  
Lease Owner Dale Reese  
Lease Name Lucy Mortimer Well No. 1  
Office Address 913 United Bldg, Salina, Kansas  
Character of Well (completed as Oil, Gas or Dry Hole) dry hole  
Date well completed 6/18/ 1966  
Application for plugging filed " 1966  
Application for plugging approved " 1966  
Plugging commenced " 1966  
Plugging completed " 1966  
Reason for abandonment of well or producing formation dry hole

NORTH

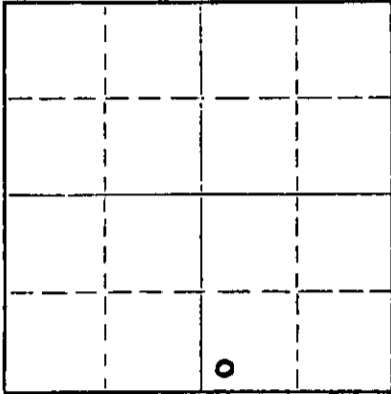

Locate well correctly on above  
Section Plat

If a producing well is abandoned, date of last production \_\_\_\_\_ 19\_\_\_\_  
Was permission obtained from the Conservation Division or its agents before plugging was commenced? yes

Name of Conservation Agent who supervised plugging of this well Scott  
Producing formation \_\_\_\_\_ Depth to top \_\_\_\_\_ Bottom \_\_\_\_\_ Total Depth of Well 2630 Feet  
Show depth and thickness of all water, oil and gas formations.

OIL, GAS OR WATER RECORDS

CASING RECORD

FORMATION	CONTENT	FROM	TO	SIZE	PUT IN	PULLED OUT
				8 5/8"	139	none

Describe in detail the manner in which the well was plugged, indicating where the mud fluid was placed and the method or methods used in introducing it into the hole. If cement or other plugs were used, state the character of same and depth placed, from \_\_\_\_\_ feet to \_\_\_\_\_ feet for each plug set.

Filled hole with mud from 2630' to 120', set wooden plug & 1/2sx hulls @ 120', put 20sx cement on top of plug, filled hole with mud to 40', set wooden plug & 1/2sx hulls @ 40', put 10sx cement on top of plug. Put 2sx cement in rat hole

*[Handwritten notes and stamps]*  
JUL 20 1966  
7-20-66  
CONSERVATION DIVISION  
WICHITA, KANSAS

(If additional description is necessary, use BACK of this sheet)

Name of Plugging Contractor Melland Drilling Co., Inc.  
Address Box 783, McPherson, Kansas

STATE OF Kansas, COUNTY OF McPherson, ss.  
Donald J. Melland (employee of owner) or (owner or operator) of the above-described well, being first duly sworn on oath, says: That I have knowledge of the facts, statements, and matters herein contained and the log of the above-described well as filed and that the same are true and correct. So help me God.

(Signature) Donald J. Melland  
Box 783, McPherson, Kansas  
(Address)

SUBSCRIBED AND SWORN to before me this 21st day of June, 1966

My commission expires December 23, 1967

Ann M. Melland  
Notary Public.

# WELL RECORD

LEASE: Lucy Mortimer

WELL NO. 1

ELEVATION: 1229 RB

LOCATION: SW SW SE  
Sec. 28-15-1W

COMMENCED: 6/13/66

COMPLETED: 6/18/66

OPERATOR: Dale Reese

CONTRACTOR: Melland Drilling Company, Inc.  
Post Office Box 783  
McPherson, Kansas

CASING RECORD: 4 5/8" @ 1321,90sx

FORMATION	LOG	FORMATION	LOG
surface clay	75		
anhydrite	162		
shale & lime	377		
lime & shale	772		
shale	1140		
lime & shale	2545		
shale	2623		
Mississippi	2630		
RTD	2630		
Sample Tests			
Lansing	1955		
Mississippian	2622		

*[Handwritten signature]*  
 STATE OF KANSAS  
 COUNTY OF MCPHERSON  
 NOTARY PUBLIC  
 JUNE 21 1966

### CERTIFICATE

State of Kansas, County of McPherson, ss.

I, Donald J. Melland, do hereby certify that the above is a true and correct copy of the log of the above named and described well, as reflected by the records of the Melland Drilling Company, Inc.

*[Handwritten signature]*

Subscribed and sworn to before me, a Notary Public, in and for the County of McPherson, State of Kansas, this 21st day of June, 1966.

My Commission expires: December 23, 1967

*[Handwritten signature]*  
 Notary Public