

Give All Information Completely  
Make Required Affidavit  
Mail or Deliver Report to:  
Conservation Division  
State Corporation Commission  
211 No. Broadway  
Wichita, Kansas

WELL PLUGGING RECORD

Saline County. Sec. 28 Twp. 15 Rge. 1 XXXXX (W)

Location as "NE/CNW/SW" or footage from lines SE/4 SW/4 NW/4

Lease Owner Saline Basin Petroleum Co.

Lease Name Knopf Well No. 1

Office Address 119 South Santa Fe, Salina, Kansas 67401

Character of Well (completed as Oil, Gas or Dry Hole)

Date well completed April 28, 19 66

Application for plugging filed 19

Application for plugging approved 19


Plugging commenced 19

Plugging completed April 28, 19 66

Reason for abandonment of well or producing formation Hole dry

If a producing well is abandoned, date of last production 19

Was permission obtained from the Conservation Division or its agents before plugging was commenced? Yes

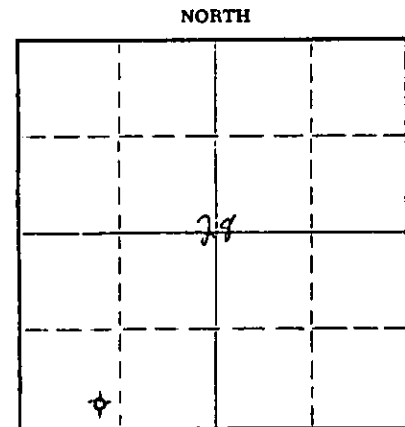

Locate well correctly on above Section Plat

Name of Conservation Agent who supervised plugging of this well Gilbert Toman

Producing formation Depth to top Bottom Total Depth of Well Feet

Show depth and thickness of all water, oil and gas formations.

OIL, GAS OR WATER RECORDS

CASING RECORD

FORMATION	CONTENT	FROM	TO	SIZE	PUT IN	PULLED OUT
Shale		0	60			
Anhydrate		60	121	8 5/8"	121'	None

Describe in detail the manner in which the well was plugged, indicating where the mud fluid was placed and the method or methods used in introducing it into the hole. If cement or other plugs were used, state the character of same and depth placed, from feet to feet for each plug set.

Plugged hole with mud to 115 ft. Set plug with 20 sacks cement, mud to 40 ft. and set plug with 1/2 sack hulls and 10 sacks cement. 2 sacks in rathole. Plugging completed at 10:00 A.M., April 28, 1966 by Gilbert J. Toman, State Plugger of Holyrood, Kansas.

MAY 2 1966  
5-2-66  
STATE CORPORATION COMMISSION  
WICHITA, KANSAS

(If additional description is necessary, use BACK of this sheet)

Name of Plugging Contractor Blackstone Drilling, Inc.

Address Box # 455, McPherson, Kansas 67460

STATE OF KANSAS, COUNTY OF SALINE, ss.

Frank Vishnefske (operator) of the above-described well, being first duly sworn on oath, says: That I have knowledge of the facts, statements, and matters herein contained and the log of the above-described well as filed and that the same are true and correct. So help me God.

(Signature) F Vishnefske

119 S. Santa Fe, Salina, Kansas 67401

(Address)

SUBSCRIBED AND SWORN TO before me this 30th day of April, 1966

My commission expires March 15-1967

Ethel Nystrom Notary Public.

15-169-19039-0000

WELL LOG BUREAU KANSAS GEOLOGICAL SOCIETY  
508 East Murdock, Wichita, Kansas


**COPY**

Company- SALINE BASIN PETROLEUM  
Farm- Knopf No.1

SEC. 23 T. 15 R. 1W  
SE SW NW

Total Depth. 2600  
Comm. 4-22-66 Comp. 4-28-66  
Shot or Treated.  
Contractor. Blackstone Drlg.  
Issued. 6-11-66

County Saline  
KANSAS

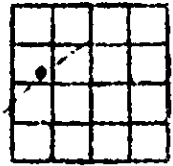

Elevation. 1250' KB

Production. Dry

Figures Indicate Bottom of Formations.

shale	60
Anhydrite	121'
lime & shale	380
lime	560
lime & shale	1820
lime	2375
shale & lime	2652
Mississippi	2680
Total Depth	

TOPS: LOG

TOPS: SAMPLE

Brown Lime	1930
Kansas City	1990
Mississippi	2652

Lansing	1990
Mississippi	2652

RECEIVED  
STATE CORPORATION COMMISSION  
APR 19 1966  
CONSERVATION DIVISION  
Wichita, Kansas



15-169-19039-0000

# Blackstone Drilling, Inc.

Box 455 • 523 West Kansas • Phone CH 1-1250

McPHERSON • KANSAS

67460

April 29, 1968

COMPANY: SALINE BASIN PETROLEUM COMPANY  
 CONTRACTOR: BLACKSTONE DRILLING, INC.  
 FARM: KNOFF # 1  
 LOCATION: SE/4 SW/4 NW/4, Sec. 28-15-1W,  
 Saline County, Kansas  
 COMMENCED: April 22, 1968  
 COMPLETED: April 28, 1968  
 ELEVATION: 1250 K.B.

0	to	60	Shale
60	to	121	Anhydrite
121	to	360	Lime & Shale
360	to	560	Lime
560	to	985	Lime & Shale
985	to	1620	Shale & Lime
1620	to	1820	Lime & Shale
1820	to	2375	Lime
2375	to	2490	Lime & Shale
2490	to	2652	Shale & Lime
2652	to	2680	Mississippi T. D.

RECEIVED  
 STATE CORPORATION COMMISSION  
 JUN 12 1968  
 CONSERVATION DIVISION  
 Wichita, Kansas

Cut 12 1/4 in. hole to 121 foot and run 123 ft. of 8 3/8 in. surface pipe and cemented with 85 sacks on bottom at 121 ft. Plug down at 11:30 A.M., April 22, 1968. Cut 7 7/8 in. hole to 2680 ft. Hole dry and abandoned. Plugged hole with mud to 115 ft. Set plug with 20 sacks cement, mud to 40 ft. & set plug with 1/2 sack balls and 10 sacks cement. 2 sacks in rethole. Plugging completed at 10:00 A.M., April 28, 1968 by Gilbert J. Tomson, Halyreed, Kansas, State Plugger.

TOPS: Brown Lime - 1920' Kansas City - 1990' Mississippi - 2652'

Measurements taken from K. B.

### CERTIFICATE

I, H. J. Plouffe, President of Blackstone Drilling, Inc. do hereby certify that the above and foregoing is a true and correct copy of log on your Knopf #1 located on the SE/4 SW/4 NW/4 of Sec. 28-15-1W, Saline County, Kansas as reflected by the files of Blackstone Drilling, Inc.

*H. J. Plouffe*  
 H. J. Plouffe, President

Subscribed and sworn to before me a Notary Public in and for McPherson County, Kansas this 29<sup>th</sup> day of April, 1968.

*Ruth McVay*  
 Ruth McVay - Notary Public



My Commission Expires: December 18, 1969.