


STATE OF KANSAS  
STATE CORPORATION COMMISSION

Form CP-4

WELL PLUGGING RECORD

Give All Information Completely  
Make Required Affidavit  
Mail or Deliver Report to:  
Conservation Division  
State Corporation Commission  
212 No. Market  
Wichita, Kansas 67202

NORTH

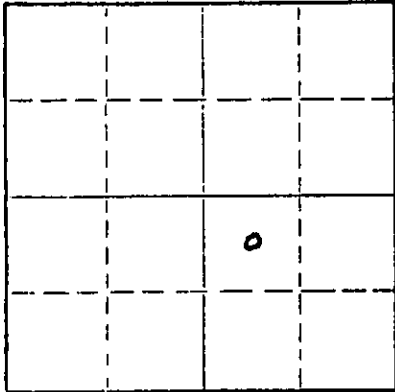

Locate well correctly on above  
Section Plat

Saline County, Sec 30 Twp 15 Rge. 1 ~~XX~~ (W)  
Location as "NE/CNW%SW%" or footage from lines C NW SE  
Lease Owner Melland Drilling, Co., Inc.  
Lease Name Peterson Well No. 3  
Office Address 901 N. Main, McPherson, Kansas 67460  
Character of Well (completed as Oil, Gas or Dry Hole) Dry  
Date well completed July 2, 19 70  
Application for plugging filed 19  
Application for plugging approved 19  
Plugging commenced 19  
Plugging completed July 2, 19 70  
Reason for abandonment of well or producing formation Dry Hole

If a producing well is abandoned, date of last production 19  
Was permission obtained from the Conservation Division or its agents before plugging was commenced? Yes

Name of Conservation Agent who supervised plugging of this well Gilbert Toman  
Producing formation Depth to top Bottom Total Depth of Well Feet  
Show depth and thickness of all water, oil and gas formations.

OIL, GAS OR WATER RECORDS

CASING RECORD

FORMATION	CONTENT	FROM	TO	SIZE	PUT IN	PULLED OUT
Lime		0	115'	8 5/8"	115'	None

Describe in detail the manner in which the well was plugged, indicating where the mud fluid was placed and the method or methods used in introducing it into the hole. If cement or other plugs were used, state the character of same and depth placed, from feet to feet for each plug set.

Set plug at 115 ft. and filled with cement to top. Plugging completed by State Pluggger, Gilbert Toman, Holyrood, Kansas.

RECEIVED  
STATE CORPORATION COMMISSION  
JUL 24 1970  
CONSERVATION DIVISION  
Wichita, Kansas

RECEIVED  
STATE CORPORATION COMMISSION  
JUL 22 1970  
CONSERVATION DIVISION  
Wichita, Kansas

(If additional description is necessary, use BACK of this sheet)


Name of Plugging Contractor Blackstone Drilling, Inc.  
Address Box 455, McPherson, Kansas 67460

STATE OF Kansas, COUNTY OF McPherson, ss.  
Donald J. Melland (Employee of owner) of (owner or operator) of the above-described

well, being first duly sworn on oath, says: That I have knowledge of the facts, statements, and matters herein contained and the log of the above-described well as filed and that the same are true and correct. So help me God.

(Signature) BY: Donald J. Melland  
MELLAND DRILLING CO., INC.  
901 N. Main, McPherson, Kansas 67460  
(Address)

Subscribed and sworn to before me this 23 day of July, 1970  
James A. Scherer  
Notary Public.

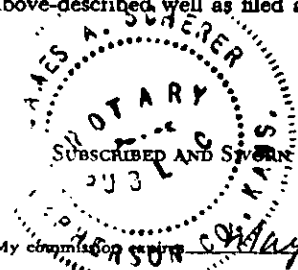



15-169-20045-0000

# Blackstone Drilling, Inc.

Box 455 • 523 West Kansas • Phone CH 1-1250

McPHERSON, KANSAS 67460

June 7, 1970

COMPANY: MELLAND DRILLING CO., INC.  
 CONTRACTOR: BLACKSTONE DRILLING, INC.  
 FARM: PETERSON #3  
 LOCATION: C NW/4 SE/4, Sec. 30-15-1W,  
 Saline County, Kansas  
 COMMENCED: June 27, 1970  
 COMPLETED: July 2, 1970  
 ELEVATION: 1316 K. B.

0	to	115	Lime
115	to	435	Shale & Lime
435	to	995	Lime & Shale
995	to	1425	Shale & Lime
1425	to	1975	Lime & Shale
1975	to	2060	Shale & Lime
2060	to	2145	Lansing
2145	to	2835	Lime
2535	to	2694	Lime & Shale
2694	to	2725	Mississippi
		2725	T. D.

RECEIVED  
 STATE CORPORATE COMMISSION  
 JUL 22 1970  
 CONSERVATION DIVISION  
 Wichita, Kansas

Cut 12 1/4 in. hole to 115 ft. and run 117 ft. of 8 5/8 in. surface pipe, cemented with 100 sacks at 115 ft. Plug down at 10:45 A. M., June 27, 1970. Cut 7 7/8 in. hole to 2725 ft. Hole dry and abandoned. Set plug at 115 ft. and filled with cement to top. Plugging completed at 4:00 A. M., July 2, 1970. Plugging completed by Gilbert Toman, State Plugger, Holyrood, Kansas.

TOPS: LANSING - 2145'      BROWN LIME - 2003'      MISSISSIPPI - 2694'

Measurements taken from K. B.

### CERTIFICATE

I, H. J. Plouffe, President of Blackstone Drilling, Inc. do hereby certify that the above and foregoing is a true and correct copy of log on your Peterson #3, located on the C NW/4 SE/4, Sec. 30-15-1W, Saline County, Kansas as reflected by the files of Blackstone Drilling, Inc.

H. J. Plouffe, President

Subscribed and sworn to before me a Notary Public in and for McPherson County, Kansas this 7th day of July, 1970.

Johnnie L. Schmidt - Notary Public

My Commission Expires: June 27, 1973.

