


STATE OF KANSAS
STATE CORPORATION COMMISSION

WELL PLUGGING RECORD

Give All Information Completely
Make Required Affidavit
Mail or Deliver Report to:
Conservation Division
State Corporation Commission
212 No. Market
Wichita, Kansas

NORTH

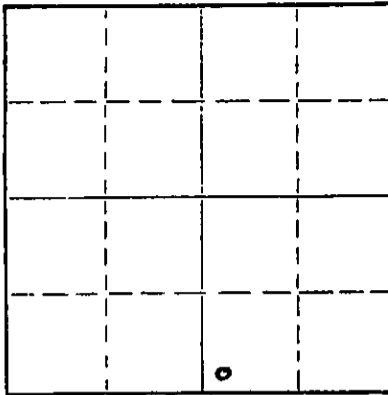

Locate well correctly on above
Section Plat

Saline County. Sec. 30 Twp. 15 Rge. 1 XXXXXX (W)
Location as "NE/CNWxSWx" or footage from lines SW/4 SW/4 SE/4
Lease Owner MELLAND DRILLING CO., INC.
Lease Name Peterson Well No. 2
Office Address 901 N. Main, McPherson, Kansas 67460
Character of Well (completed as Oil, Gas or Dry Hole) Dry Hole
Date well completed January 27, 1970
Application for plugging filed 19
Application for plugging approved 19
Plugging commenced 19
Plugging completed January 27, 1970
Reason for abandonment of well or producing formation Hole Dry

If a producing well is abandoned, date of last production 19
Was permission obtained from the Conservation Division or its agents before plugging was commenced? Yes

Name of Conservation Agent who supervised plugging of this well Hugh Scott
Producing formation _____ Depth to top _____ Bottom _____ Total Depth of Well _____ Feet
Show depth and thickness of all water, oil and gas formations.

OIL, GAS OR WATER RECORDS

CASING RECORD

FORMATION	CONTENT	FROM	TO	SIZE	PUT IN	PULLED OUT
Lime		0	112	8 5/8	112	None

RECEIVED
STATE CORPORATION COMMISSION
FEB 12 1970
CONSERVATION DIVISION
WICHITA, KANSAS

Describe in detail the manner in which the well was plugged, indicating where the mud fluid was placed and the method or methods used in introducing it into the hole. If cement or other plugs were used, state the character of same and depth placed, from _____ feet to _____ feet for each plug set.

Filled with mud to 110 ft. and set plug.
Put 25 sacks of cement and filled with mud to 40 ft. and set plug. Put in 10 sacks of cement. Two sacks of cement in rathole. Plug down at 5:00 P. M. January 27, 1970. Plugging completed by Hugh Scott, State Plugger, McPherson, Kansas.

(If additional description is necessary, use BACK of this sheet)

Name of Plugging Contractor Blackstone Drilling, Inc.
Address Box 455, McPherson, Kansas 67460

STATE OF Kansas, COUNTY OF McPherson, ss.

Donald J. Melland (employee of owner) or (owner or operator) of the above-described well being first duly sworn on oath, says: That I have knowledge of the facts, statements, and matters herein contained and the log of the above described well as filed and that the same are true and correct. So help me God.


(Signature) Donald J. Melland

901 N. Main, McPherson, Kansas 67460
(Address)

Subscribed and sworn to before me this 30 day of January, 1970

My commission expires May 7, 1970

Notary Public.

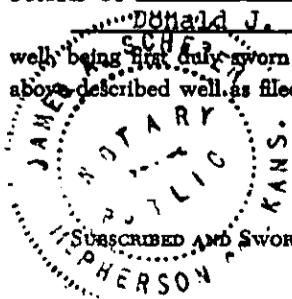



15-169-20033-0000

Blackstone Drilling, Inc.

Box 455 • 523 West Kansas • Phone CH 1-1250

McPHERSON, KANSAS 67460

January 28, 1970

COMPANY: WYLLAND DRILLING CO., INC.
 CONTRACTOR: BLACKSTONE DRILLING, INC.
 FARM: PETERSON #2
 LOCATION: SW/4 SW/4 SE/4, Sec. 30-15-1
 Saline County, Kansas
 COMMENCED: January 21, 1970
 COMPLETED: January 27, 1970
 ELEVATION: 1818 K. B.

0	to	112	Line
112	to	250	Line & Shale
250	to	700	Line
700	to	1230	Shale & Line
1230	to	1505	Line & Shale
1505	to	2000	Line
2000	to	2084	Line & Shale
2084	to	2470	Line
2470	to	2610	Line & Shale
2610	to	2717	Shale & Line
2717	to	2743	Mississippi
		2743	T. D.

RECEIVED
 STATE CORPORATION COMMISSION
 FEB 12 1970
 CONSERVATION DIVISION
 Wichita, Kansas

Cut 12 1/4 in. hole to 112 ft. and run 115 ft. of 8 5/8 in. surface pipe, cemented with 115 sacks of cement at 112 ft., Plug down at 5:30 P. M., January 21, 1970. Cut 7 7/8 in. hole to 2743 ft. Hole dry and abandoned. Filled with mud to 110 ft. Set plug and put in 25 sacks of cement. Filled with mud to 40 ft. and set plug with 10 sacks of cement. Two sacks of cement in rathele. Plugging completed at 5:00 P. M., January 27, 1970. Plugging completed by State Plugger, Hugh Scott, McPherson, Kansas.

TOPS: BROWN LINE - 2007' LANSING - 2075' MISSISSIPPI - 2695'

Measurements taken from K. B.

CERTIFICATE

I, H. J. Plouffe, President of Blackstone Drilling, Inc. do hereby certify that the above and foregoing is a true and correct copy of log on your Peterson #2, located on the SW/4 SW/4 SE/4 30-15-1, Saline County as reflected by the files of Blackstone Drilling, Inc.

H. J. Plouffe, President

Subscribed and sworn to before me a Notary Public in and for McPherson County, Kansas this 29 day of January, 1970.

Johnnie L. Schmidt - Notary Public

My Commission Expires: June 27, 1973.

