

15169-20159-0000


STATE OF KANSAS  
STATE CORPORATION COMMISSION

WELL PLUGGING RECORD

Give All Information Completely  
Make Required Affidavit  
Mail or Deliver Report to  
Conservation Division  
State Corporation Comm.  
245 North Water  
Wichita, KS 67202

Saline County, Sec. 30 Twp. 15S Rge. 1 xE/W  
Location as "NE/CNW}SW}" or footage from lines  
200' W N/2 N/2 NW

Lease Owner Range Oil Company, Inc.  
Lease Name McCarty Well No.: 1  
Office Address 240 Page Court, 220 W. Douglas, Wichita, Kansas  
Character of Well (Completed as Oil, Gas or Dry Hole) Dry Hole

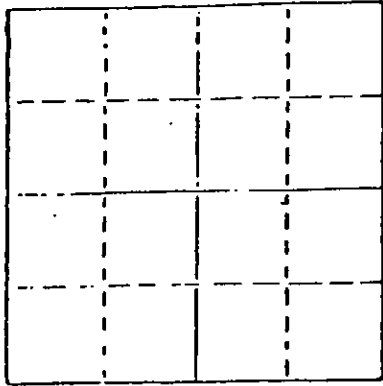

Locate well correctly on above  
Section Plat

Date Well completed 3-21 19 82  
Application for plugging filed 3-21 19 82  
Application for plugging approved 3-21 19 82  
Plugging commenced 3-21 19 82  
Plugging completed 3-21 19 82

Reason for abandonment of well or producing formation  
Dry Hole

If a producing well is abandoned, date of last production  
19

Was permission obtained from the Conservation Division or  
its agents before plugging was commenced? Yes

Name of Conservation Agent who supervised plugging of this well Gilbert Toman  
Producing formation Depth to top Bottom Total Depth of Well 2786

Show depth and thickness of all water, oil and gas formations.

OIL, GAS OR WATER RECORDS

CASING RECORD

FORMATION	CONTENT	FROM	TO	SIZE	PUT IN	PULLED OUT
				8-5/8	208	0

Describe in detail the manner in which the well was plugged, indicating where the mud fluid  
was placed and the method or methods used in introducing it into the hold. If cement or other  
plugs were used, state the character of same and depth placed, from feet to  
feet for each plug set.

Mud to 300', 50 sx cement  
Mud to 40', 1/2 sx hulls, dry hole plug, 10 sx cement  
10 sx cement in rat hole

(If additional description is necessary, use BACK of this sheet)

Name of Plugging Contractor Range Drilling Company, Inc.

STATE OF Kansas COUNTY OF Sedgwick, ss.  
Gary L. Reed (employee of owner) or (owner or operator)

of the above-described well, being first duly sworn on oath, says: That I have knowledge of  
the facts, statements, and matters herein contained and the log of the above-described well  
is filed and that the same are true and correct. So help me God.

(Signature) Gary L. Reed  
240 Page Court, 220 W. Douglas, Wichita, Kansas  
(Address)

SUBSCRIBED AND SWORN TO before me this 25<sup>th</sup> day of March, 1982

Nora S. Davidson  
Notary Public.

