


STATE OF KANSAS  
STATE CORPORATION COMMISSION

Form CP-4

Give All Information Completely  
Make Required Affidavit  
Mail or Deliver Report to:  
Conservation Division  
State Corporation Commission  
212 No. Market  
Wichita, Kansas 67202

WELL PLUGGING RECORD

NORTH

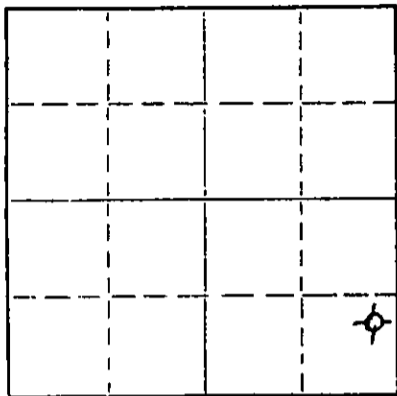

Locate well correctly on above  
Section Plat

Saline County, Sec. 30 Twp. 15 Rge. 1 ~~NE~~ (W)  
Location as "NE/CNW/SW" or footage from lines 990' NSL & 330' WEL E/2 SE/4 30-15-1W  
Lease Owner Dale Reese Oil Company  
Lease Name Hess Well No. 5  
Office Address 415 E. Prescott, Salina, Kansas 67401  
Character of Well (completed as Oil, Gas or Dry Hole) Dry  
Date well completed March 27, 1977  
Application for plugging filed 19  
Application for plugging approved 19  
Plugging commenced 19  
Plugging completed March 27, 1977  
Reason for abandonment of well or producing formation Dry Hole

If a producing well is abandoned, date of last production 19  
Was permission obtained from the Conservation Division or its agents before plugging was commenced?

Name of Conservation Agent who supervised plugging of this well Hugh Scott  
Producing formation Depth to top Bottom Total Depth of Well Feet  
Show depth and thickness of all water, oil and gas formations.

OIL, GAS OR WATER RECORDS

CASING RECORD

FORMATION	CONTENT	FROM	TO	SIZE	PUT IN	PULLED OUT
Lime		0	100'	8 5/8"	100'	None

Describe in detail the manner in which the well was plugged, indicating where the mud fluid was placed and the method or methods used in introducing it into the hole. If cement or other plugs were used, state the character of same and depth placed, from feet to feet for each plug set.

Set bottom plug at 150' with 25 sacks of cement. 2nd plug with 40' with 10 sacks of cement, 2 sacks in rathole. Plug down at 5:00 P. M., March 27, 1977. Plugging completed by State Plugger, Hugh Scott, McPherson, Kansas 67460.

4-1-77

(If additional description is necessary, use BACK of this sheet)  
Name of Plugging Contractor Blackstone Drilling, Inc.  
Address Box 1184, McPherson, Kansas 67460


STATE OF Kansas, COUNTY OF Saline, ss.  
Dale Reese Oil Company (employee of owner) or (owner or operator) of the above-described well, being first duly sworn on oath, says: That I have knowledge of the facts, statements, and matters herein contained and the log of the above-described well as filed and that the same are true and correct. So help me God. DALE REESE OIL COMPANY

(Signature) BY: Dale Reese  
415 E. Prescott, Salina, Kansas 67401  
(Address)

SUBSCRIBED AND SWORN TO before me this 31 day of March, 1977

My commission expires January 7, 1981

Paul P. Younger  
Notary Public.

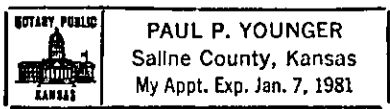

15-169-20072-0000

# Blackstone Drilling, Inc.

Box 128A 523 West Kansas • Phone (316) 241-1250  
McPHERSON, KANSAS 67460

March 28, 1977

**COMPANY:** DALE HERSE OIL COMPANY  
**CONTRACTOR:** BLACKSTONE DRILLING, INC.  
**WELL:** HESS#5  
**LOCATION:** 990' NE1 & 330' WEL E/2 SE/4, Sec. 30-130-1W, Saline County, Kansas  
**COMMENCED:** March 21, 1977  
**COMPLETED:** March 27, 1977  
**ELEVATION:** 1319 K. B.

0	to	100	Line
100	to	410	Line & Shale
410	to	695	Line
695	to	955	Line & Shale
955	to	1349	Shale
1349	to	1680	Shale & Line
1680	to	2595	Line
2595	to	2671	Shale
2671	to	2727	Mississippi
		2727	T. D.

Cut 1 3/4" hole to 100' and run 102' of 8 3/8" surface pipe, cemented with 100 sacks of cement at 100'. Plug down at 1:00 P. M., March 22, 1977. Cut 7 7/8" hole to 2727'. Hole dry and abandoned. Set 1st plug at 150' with 25 sacks of cement. Set 2nd plug at 40' with 10 sacks of cement, 2 sacks in rethole. Plugging completed at 5:00 P. M., March 27, 1977. Plugging completed by Hugh Scott, McPherson, Kansas, State Plugger.

**TOPS:** LANSING - 2054' MISSISSIPPI - 2671'

Measurements taken from K. B.

### CERTIFICATE

I, F. E. Plouffe, President of Blackstone Drilling, Inc. do hereby certify that the above and foregoing is a true and correct copy of log on your Well #5, located on the 990' NE1 & 330' WEL of E/2 SE/4, Section 30-130-1W, Saline County, Kansas as reflected by the files of Blackstone Drilling, Inc.

  
F. E. Plouffe, President

Subscribed and sworn to before me a Notary Public in and for McPherson County, Kansas this 28th day of March, 1977.

  
Johnnie L. Schmidt - Notary Public

