


WELL PLUGGING RECORD

Give All Information Completely
Make Required Affidavit
Mail or Deliver Report to:
Conservation Division
State Corporation Commission
211 No. Broadway
Wichita, Kansas

Saline County, Sec. 29 Twp. 15S Rge. 1W (E) (W)
Location as "NE/CNW&SW" or footage from lines SW SW SE
Lease Owner Veeder Supply and Development Co.
Lease Name Andrew Nelson Well No. 1
Office Address Box 201, Cherryvale, Kansas
Character of Well (completed as Oil, Gas or Dry Hole) Dry Hole
Date well completed March 29, 1958 19
Application for plugging filed March 29, 1958 19
Application for plugging approved March 29, 1958 19
Plugging commenced March 29, 1958 19
Plugging completed March 29, 1958 19
Reason for abandonment of well or producing formation Dry Hole

NORTH

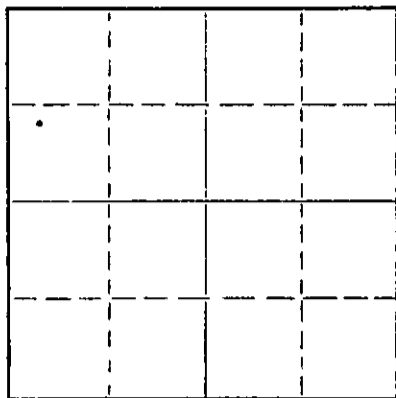

Locate well correctly on above
Section Plat

If a producing well is abandoned, date of last production _____ 19____
Was permission obtained from the Conservation Division or its agents before plugging was commenced? Yes

Name of Conservation Agent who supervised plugging of this well Gilbert J. Toman, Holyrood, Kansas
Producing formation _____ Depth to top _____ Bottom _____ Total Depth of Well 2740 Feet
Show depth and thickness of all water, oil and gas formations.

OIL, GAS OR WATER RECORDS

CASING RECORD

FORMATION	CONTENT	FROM	TO	SIZE	PUT IN	PULLED OUT
				8 5/8"	215' w/120	sacks

Describe in detail the manner in which the well was plugged, indicating where the mud fluid was placed and the method or methods used in introducing it into the hole. If cement or other plugs were used, state the character of same and depth placed, from _____ feet to _____ feet for each plug set.

Filled with mud to 210'; set plug with 15 sacks cement; filled with mud to 40'; set plug with 10 sacks cement.

STATE CORPORATION
4-4-58
APR 4 1958
CONSERVATION DIVISION
WICHITA, KANSAS

(If additional description is necessary, use BACK of this sheet)
Name of Plugging Contractor Veeder Supply and Development Co.
Address Box 201, Cherryvale, Kansas

STATE OF Kansas, COUNTY OF Montgomery, ss.
C. H. Woods (employee of owner) or (owner or operator) of the above-described well, being first duly sworn on oath, says: That I have knowledge of the facts, statements, and matters herein contained and the log of the above-described well as filed and that the same are true and correct. So help me God.

(Signature) C. H. Woods
Cherryvale, Kansas
(Address)

SUBSCRIBED AND SWORN TO before me this 2nd day of April, 19 58

Iles Lawson
Notary Public.

My commission expires July 11, 1960

PLUGGING
FILE NO. 29-15S-1W
BOOK PAGE 91 LINE 24

Veeder Supply & Dev'l. Co.



Cherryvale, Kansas

Drilled for Veeder Supply & Development Company
Maurice L. Briedenthal, Sr. D. A. Will-Farm Andrew Nelson No. 1 Depth 2740'
bern & E. A. Mungenback
 Contractor Veeder Supply & Development Co. Pipe 215' 8 5/8" csg. w/120 sacks
 Location SW/4 SW/4 SE/4 Sec. 29 Twp. 15S Range 1W
 Commenced 3-22-58 Completed 3-29-58 County Saline State Kansas

Cellar	0	9	9	Elevation: 1314 Gr.	
Yellow Clay	9	40	31	1319 DF	
Lime	40	80	40	1320 RB	
Lime shale	80	437	357		
Shale and lime	437	615	178	TOPS:	
Lime and shale	615	775	160	Lansing KC	2056'
Shale and lime	775	808	33	Miss. Lime	2690'
Lime and shale	808	965	157		
Shale and lime streaks	965	1025	60		
Shale	1025	1085	60		
Shale w/lime streaks	1085	1195	110		
Lime	1195	1225	30		
Lime and shale	1225	1415	190		
Shale w/lime shells	1415	1578	163		
Shale and lime	1578	1763	185		
Lime w/shale streaks	1763	1825	62		
Shale and lime	1825	1949	124		
Lime	1949	1971	22		
Shale and lime	1971	2047	76		
Lime and shale	2047	2131	84		
Lime w/shale breaks	2131	2278	147		
Lime	2278	2365	87		
Lime and shale	2365	2602	237		
Shale and lime	2602	2627	25		
Lime and shale streaks	2627	2650	23		
Lime and shale	2650	2705	55		
Lime	2705	2740	35		
T. D.	2740				
D&A					

AFFIDAVIT

STATE OF KANSAS)
Montgomery County) SS

C. H. Woods, of lawful age, being first duly sworn on oath, deposes and says:

THAT he has read the above drilling log covering the Andrew Nelson well #1 located in Section 29-15S-1W. Saline County, Kansas, and that the same is true and correct. Further affiant saith not.

THE VEEDER SUPPLY AND DEVELOPMENT CO.

By- C. H. Woods
C. H. Woods

Subscribed and sworn to before me this 2nd day of April, 1958.

Edna Lawson
Notary Public

My Commission Expires July 11, 1960.

PLUGGING
 FILE SEC 29 T. 15 R. 1W
 BOOK PAGE 91 LINE 24